

The ARC Building (Taxi)

30-02 39 Avenue

Queens, NY 11101

As-Built April 2020

Submitted to:

Frontier Energy
2695 Bingley Road
Cazanovia, NY 13035

Submitted by:

Tecogen, Inc.
45 First Ave
Waltham, MA 02451
781.466.6400
www.Tecogen.com

Measurement & Verification Plan for CHP System at The ARC Building

Project Team:

MEP Principal Engineer:

Ventrop Engineering Consulting Group, PLLC
365 West 34th Street
New York, NY 10001
T: 212.244.5060
www.ventrop.com

Developer:

Rick Christian
Project Manager
Tecogen, Inc.
45 First Avenue
Waltham, MA 02451
T: 732.208.8548
E: richard.christian@tecogen.com

Owner/Management Group:

Mathew Niskanen
Senior Property Manager
The Lightstone Group
460 Park Avenue
13th Floor
New York, NY 10022
T: 646.235.0789
E: mniskanen@lightstonegroup.com

Measurement & Verification Plan for CHP System at The ARC Building

1. Introduction

Tecogen, Inc. (Tecogen) supported the installation of a combined heat and power (CHP) system at The ARC Building (known as Taxi throughout this application). The site is receiving an incentive from NYSERDA, of which the first two milestones have been paid out in full. The CHP system includes two (2) INV-e+ 100kW engine generator unit. The inverter-based system is intended to produce a gross output of 100 kW and recover engine jacket water and exhaust heat recovery for:

- a) Pre-heating the hot water loop which in turn heats:
 - i. DHW heating
 - ii. Space Heating
 - iii. Pool

The CHP system will provide power in parallel with the existing utility service, as well as the capabilities to operate in island-mode and provide backup power during an outage scenario.

2. Instrumentation

In order to quantify the performance of the CHP system, the CHP system fuel input, net electrical output, and useful thermal output will be measured. To capture that data Tecogen supplied the meters and instrumentation listed in **Table 1 on page 4**.

Data Logger

Readings for the installed instrumentation are recorded by a CHPInsight datalogger provided and installed by Tecogen. The computer samples all sensors approximately once per 30 seconds and records the information. The readings of heat recovery temperatures and flow rates will be used to provide an accurate calculation of heat transfer on the heat recovery loops, which are all continuous flow loops. Based on the number of monitored data points, the logger will have sufficient memory to store 3-days of data if communications with the logger are interrupted.

The data will be downloaded from CHPInsight once per day via an Internet connection provided by the Site. The data will be loaded into a Tecogen database for long term storage and checked for validity.

Onsite Installation

The contractor installed a CHPInsight panel in the boiler room near the CHP unit. The monitoring system panel is approximately 2 ft x 16 in x 10 in. The panel is supplied with 120 VAC power (it requires 1 amp or less). The panel is conveniently located relative to the sensors listed above as well as the communications line provided by the site.

Communications

The CHPInsight has a connection to the Internet. An IP address has been supplied. The logger uploads data every night to the Tecogen servers, is compiled into a csv file, and then distributed on an annual basis and provided to NYSERDA based on their monitoring requirements.

Measurement & Verification Plan for CHP System at The ARC Building

On Site Support

The facility has assisted in providing a network connection for the CHPInsight. Tecogen is responsible for providing a complete monitoring installation, as well as any access for return trips to verify sensors or service the monitoring system.

Table 1. Overview of CHP System Monitoring Instrumentation

| Data Point | Tecogen Label | Description | Units | Instrument / Sensor | Output Type | Location |
|-------------------|---------------|--|------------|---------------------|-------------|----------------|
| P _{NET} | EM-1 | Generator NET Electrical Output | kW/ kWh | Veris E50C2 | ModBus | Electric Room |
| P _{OUT} | INV | Generator Gross Electrical Output | kW/ kWh | InVerde | On-Board | Roof Mech Room |
| G _{IN} | GM-1 | Net Generator Fuel Input | CF | Gas Meter Pulse | Pulse | Gas Meter Room |
| T _{OUT1} | BTU-TS-1 | Engine Heating Module Supply Temperature | °F | Onicon System 10 | ModBus | Roof Mech Room |
| T _{RET1} | BTU-TS-2 | Engine Heating Module Usable HeatTemperature | °F | Onicon System 10 | ModBus | Roof Mech Room |
| F _{NET1} | BTU-1 | Engine Heating Module System Flow | GPM | Onicon System 10 | ModBus | Roof Mech Room |
| Q _{NET1} | BTU-1 | CHP Engine Heat Supplied | BTUh | Onicon System 10 | ModBus | Roof Mech Room |

3. Data Analysis

The collected data listed in Table 1 on page 4 will be used to determine the net power output of the system as well as the fuel conversion efficiency (FCE).

Peak Demand or Peak kW

The peak electric output or demand for each power reading will be taken as the average kW in a fixed 15-minute interval (0:00, 0:15, 0:30, etc.), defined as:

$$kW = \frac{\sum_{15 \text{ min}} kWh}{\Delta T} = \frac{kWh \text{ per interval}}{0.25h}$$

Net Power Output

The power meter will measure the generator power output (P_{OUT}). The internal generator meter will measure the gross output of the engine generator as a check.

The parasitic power (P_{PAR}) is estimated to be 5 kW. The net power (P_{NET}) can be determined by subtracting parasitic power (P_{PAR}) from the power output (P_{OUT}).

$$kW_{NET} = P_{OUT} - P_{PAR}$$

Measurement & Verification Plan for CHP System at The ARC Building

Heat Recovery Rates

The heat recovery rates will be calculated based on the 30 second interval data collected. The piping arrangement at this site allows for the total recoverable heat rate to be determined at one location as there is no heat rejection unit included with the installation:

The rate of useful heat recovery in Btu/h is defined as:

$$Q_{NET} = C_p \times \sum (F_{NET} \times (T_{OUT} - T_{RET}) \times n)$$

where: $C_p = \sim 500$ Btu/h-gpm-°F for pure water;
 n = Number of 1-minute intervals included in period of interest

The heat recovery loop fluid is expected to be pure water.

Any heat recovery measurement can be calculated for an interval sum (Btu) by the following:

Calculated Quantities

The fuel conversion efficiency (FCE) of the CHP system, based on the higher heating value of the fuel, will be defined as:


$$FCE = \frac{Q_{NET} + (3413 \times P_{NET})}{G_{IN} \times HHV_{Gas}}$$

where: Q_{Net} = Total Useful heat recovery (Btu) (QU)
 P_{Net} = Engine generator net output (kWh)
 G_{in} = Generator gas consumption (Std CF)
 HHV_{gas} = Higher heating value for natural gas (~ 1020 Btu/CF)

The FCE can be calculated for any time interval of interest (hourly, daily, monthly, etc.), depending on the resolution available for the gas meter reading.

Appendix A
System Schematics

- SEQUENCE OF OPERATIONS FOR STAND ALONE (GRID-ISOLATED) MODE:
1. AFTER A POWER FAILURE CONDITION, VERIFY THE MACHINES HAVE RECEIVED A RELAY FAILURE ALARM.
 2. TURN BREAKER 52IT TO OFF POSITION AND REMOVE KIRK KEYS
 3. INSERT KIRK KEYS INTO MACHINES AND TURN, THEY WILL START AUTOMATICALLY
 4. WHEN POWER IS RESTORED TO THE BUILDING, THE MACHINES WILL TURN OFF.
 5. REMOVE KEYS AND REPLACE THEM IN 52IT AND RETURN BREAKER TO ON POSITION.

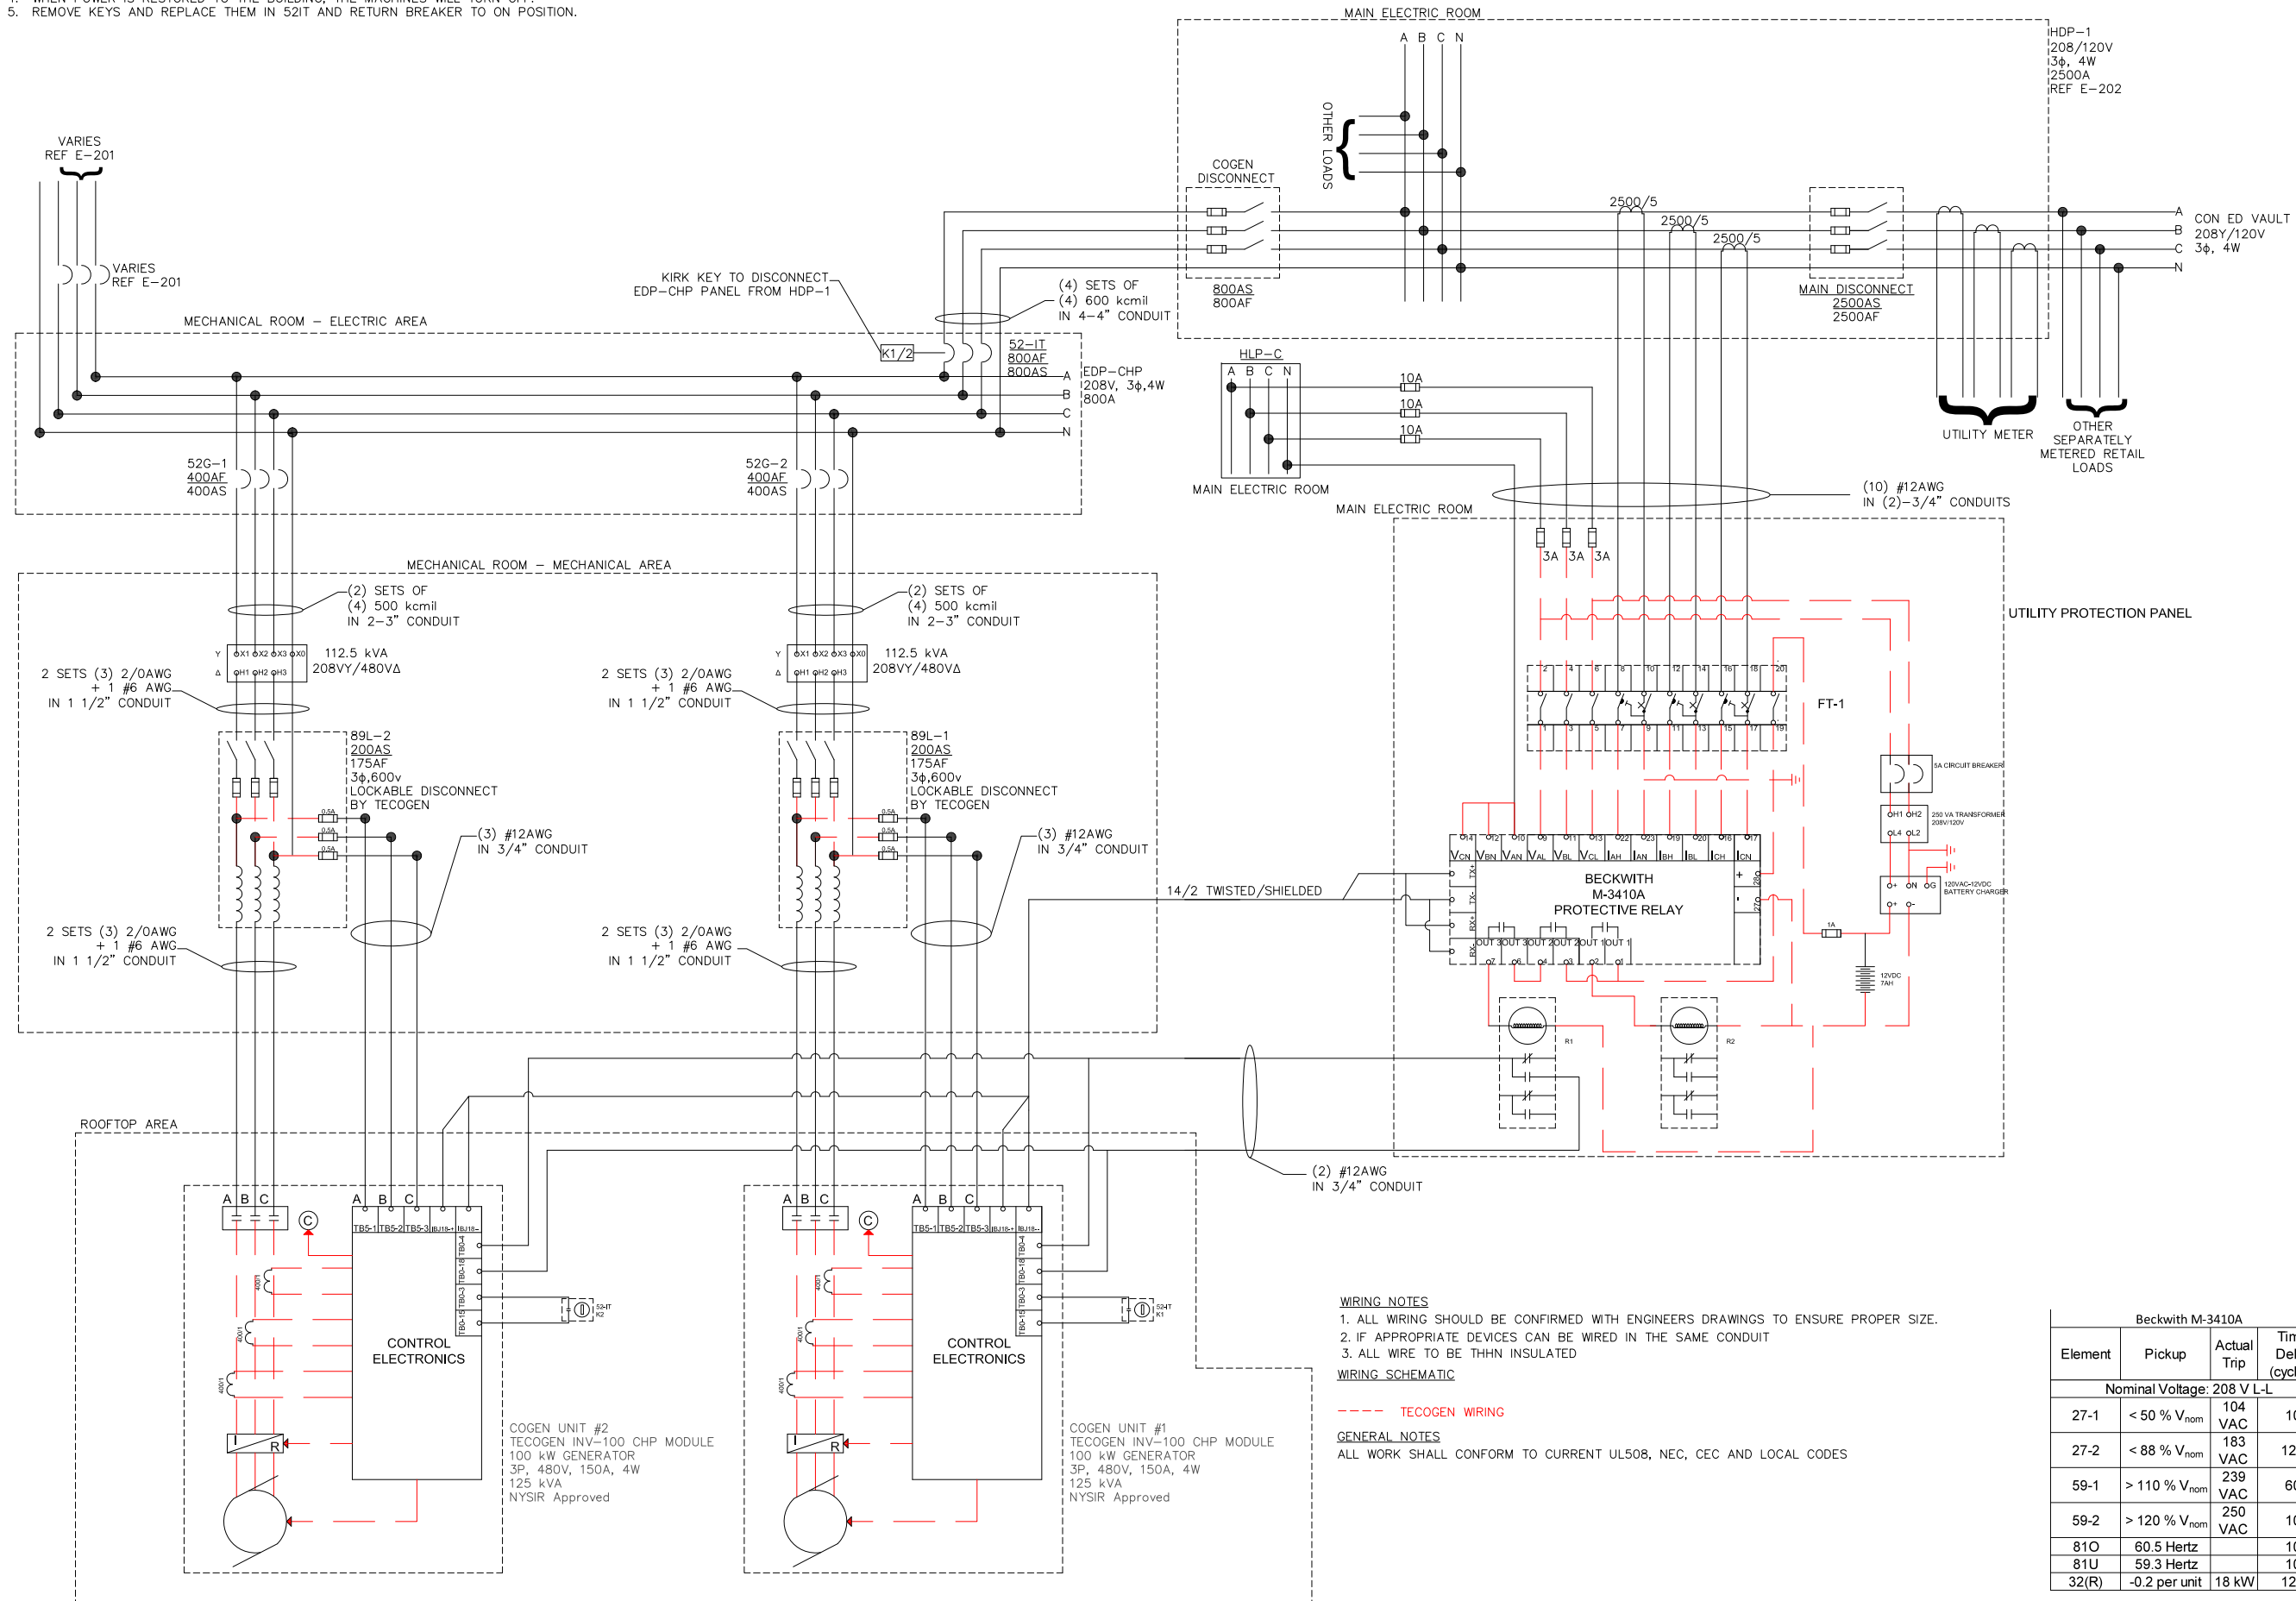

WIRING NOTES

1. ALL WIRING SHOULD BE CONFIRMED WITH ENGINEERS DRAWINGS TO ENSURE PROPER SIZE.
2. IF APPROPRIATE DEVICES CAN BE WIRED IN THE SAME CONDUIT
3. ALL WIRE TO BE THHN INSULATED

WIRING SCHEMATIC

----- TECOGEN WIRING

GENERAL NOTES

ALL WORK SHALL CONFORM TO CURRENT UL508, NEC, CEC AND LOCAL CODES

| Beckwith M-3410A | | | |
|----------------------------|--------------------------|-------------|---------------------|
| Element | Pickup | Actual Trip | Time Delay (cycles) |
| Nominal Voltage: 208 V L-L | | | |
| 27-1 | < 50 % V _{nom} | 104 VAC | 10 |
| 27-2 | < 88 % V _{nom} | 183 VAC | 120 |
| 59-1 | > 110 % V _{nom} | 239 VAC | 60 |
| 59-2 | > 120 % V _{nom} | 250 VAC | 10 |
| 81O | 60.5 Hertz | | 10 |
| 81U | 59.3 Hertz | | 10 |
| 32(R) | -0.2 per unit | 18 kW | 120 |



45 FIRST AVE, WALTHAM, MA 02451
(781) 466-6400
WWW.TECOGEN.COM

MECHANICAL ENGINEER

ELECTRICAL ENGINEER

PE STAMP/SEAL

| DATE | REV | DESCRIPTION |
|---------|-----|--------------------|
| 5/27/16 | 1 | REV TO MATCH E-501 |
| 6/11/19 | 2 | AS BUILT |

30-02 39th Ave.
Queens, NY 11101
CHP System

PROJECT


8/25/16 DATE
RJC DRAWN BY

COGEN THREE LINE
DRAWING TITLE

E-1

DRAWING NUMBER

Location of Electric Meter EM-1

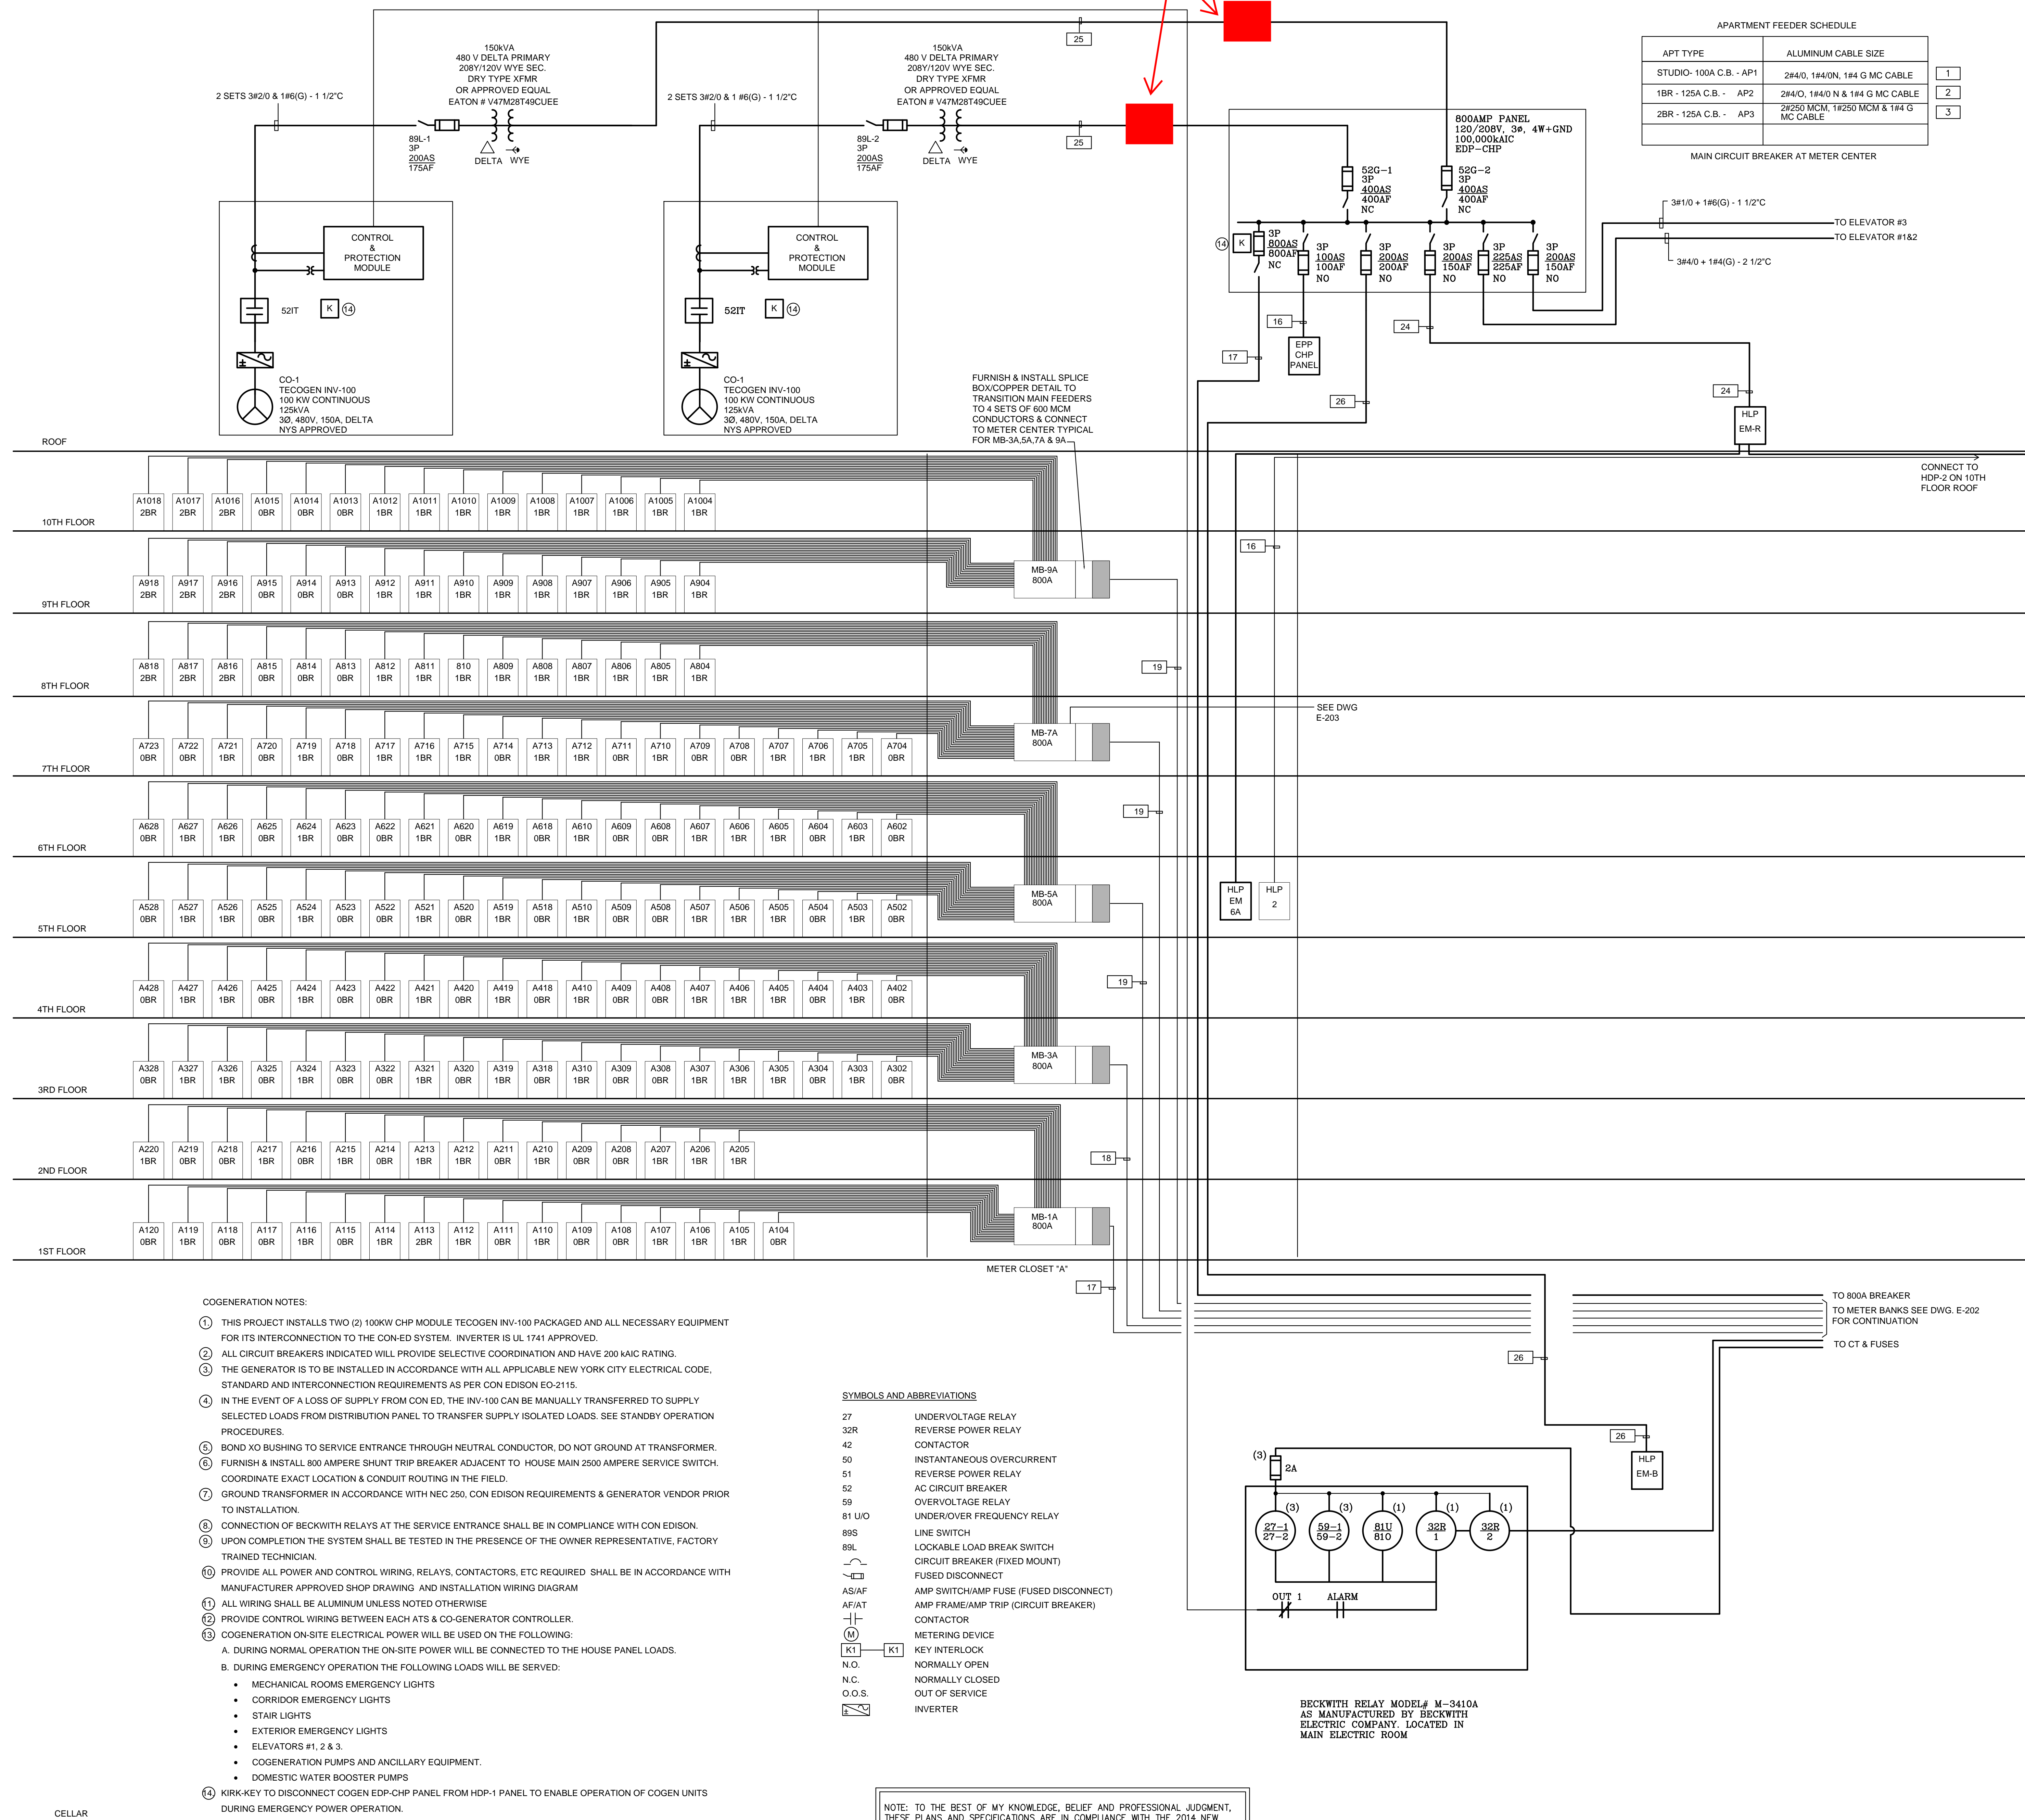

APARTMENT FEEDER SCHEDULE

| APT TYPE | ALUMINUM CABLE SIZE | |
|------------------------|---------------------------------------|---|
| STUDIO-100A C.B. - AP1 | 2#410, 1#440N, 1#4 G MC CABLE | 1 |
| 1BR - 125A C.B. - AP2 | 2#410, 1#440 N & 1#4 G MC CABLE | 2 |
| 2BR - 125A C.B. - AP3 | 2#250 MCM, 1#250 MCM & 1#4 G MC CABLE | 3 |

- NOTES:
- PROVIDE DUAL ELEMENT TIME-DELAY FUSES FOR ELEVATORS.
 - PROVIDE SUB-FEED LUGS FOR ALL 2 SECTION PANELS. CONTRACTOR IS PERMITTED TO USE SINGLE SECTION #4 POLE PANEL IN LIEU OF 2 SECTION PANEL. REFER TO PANEL SCHEDULE FOR ADDITIONAL INFORMATION.
 - ELECTRICAL CONTRACTOR IS RESPONSIBLE FOR SHORT CIRCUIT COORDINATION STUDY. ADJUST SHORT CIRCUIT RATING TO PANELS WHERE REQUIRED. STUDY MUST BE PERFORMED PRIOR TO FABRICATION OF SWITCHGEAR, METER CENTER AND PANELS. SUBMIT SHORT CIRCUIT REPORT ALONG WITH THE SWITCHGEAR & PANEL SHOP DRAWINGS.
 - FIRE ALARM POWER FEEDERS SHALL BE COPPER INSTALLED IN RIGID GALVANIZED STEEL.
 - G.C TO PROVIDE 4" HOUSE KEEPING PAD FOR ALL FLOOR MOUNTED ELECTRICAL EQUIPMENT.
 - PROVIDE 8-4" CONDUIT SLEEVES AT THE FOUNDATION WALL TO SERVICE END BOX # 1 & 2 IN ACCORDANCE WITH CON EDISON REQUIREMENTS.
 - WHERE ALUMINUM OR COPPER-CLAD ALUMINUM CABLE ARE USED ALL PANELBOARDS, DISTRIBUTION PANEL SWITCHES, ETC SHALL BE PROVIDED WITH SUITABLE BUS RATINGS & LUGS TO ACCEPT THESE CABLES.
 - ALL COPPER OR COPPER-CLAD CABLES SHALL HAVE A MINIMUM RATING NOT LESS THAN 7500 C.
 - PROVIDE 2" EMPTY CONDUIT FROM EACH ELEVATOR PIT TO FRONT DESK FOR "EMS" & SECURITY SYSTEM.
 - WITHIN THE ELECTRICAL ROOM PROVIDE A MINIMUM OF 3 FEET CLEARANCE FROM ANY ELECTRICAL EQUIPMENT, RAILING, DOORS, ETC. PROVIDE FULLY COORDINATE ROOM LAYOUT FOR THE ENGINEER APPROVAL PRIOR TO COMMENCING ANY WORK.
 - CONTRACTOR IS REQUIRED TO PREPARE & FILE ELECTRICAL ONE LINE & SWITCHBOARD ROOM LAYOUT WITH NYC BUREAU OF ELECTRICAL CONTROLS FOR APPROVAL PRIOR TO FABRICATION & OR INSTALLATION OF ANY EQUIPMENT.
 - FIRE PUMP POWER CONDUITS TO BE INSTALLED IN THE CONCRETE SLAB OR PROVIDE 2 HOUR RATED ENCLOSURE. CONTRACTOR MAY USE CIRCUIT BREAKERS IN LIEU OF SWITCH-FUSE IN THE MAIN SWITCHBOARD. CONTRACTOR TO PROVIDE CIRCUIT BREAKERS WITH ADEQUATE SHORT CIRCUIT RATING BASE ON SHORT CIRCUIT COORDINATION STUDY.
 - PROVIDE COPPER CABLES TO FIRE ALARM SYSTEM IN ACCORDANCE WITH 2011 NYC ELECTRICAL CODE.
 - CABLE SMALLER THAN #10 WIRE SHALL BE SOLID & WIRES LARGER THAN #8 SHALL BE STRANDED.
 - PROVIDE CONTROL WIRING TO CO-GENERATOR AS PER APPROVED TECO-GEN SHOP DRAWINGS. ALL CONTROL WIRING SHALL BE INSTALLED IN 3/4" MINIMUM.
 - COORDINATE CONTROL WIRING FROM ELEVATOR CONTROLLER TO SELECTOR SWITCH IN LOBBY WITH ELEVATOR VENDOR REQUIREMENTS. INSTALL CONTROL WIRING IN 2" CONDUIT UNLESS OTHERWISE DIRECTED OTHERWISE BY VENDOR.
 - FURNISH & INSTALL TRANSIENT VOLTAGE SURGE SUPPRESSION (TVSS) AT THE MAIN SWITCHBOARD.
 - TAP JOCKEY PUMP FEED OUTSIDE THE FIRE PUMP CONTROLLER.
 - ALL PANEL LOCATED ON THE ROOF, WET OR DAMP LOCATION SHALL BE PROVIDED WITH NEMA OR ENCLOSURE.
 - WHERE ALUMINUM CABLE ARE USE & FEEDER IS NOT SUITABLE FOR LUGS IN PANEL OR SWITCHES, THE CONTRACTOR SHALL PROVIDE SUITABLE SPLICE BOX AND ASSOCIATED CUPPER DETAIL & CONNECT THE EQUIPMENT WITH SUITABLE CABLE RATING TO MATCH AVAILABLE LUGS ON THE EQUIPMENT.
 - WHERE MC CABLE ARE USE PROVIDE A GROUNDING CONDUCTOR SIZES AS PER NEC 250.

FEEDER SCHEDULE

| DESIGNATION | DESCRIPTION | REMARKS |
|-------------|--|--------------|
| 1 | 2#410, 1#440N, 1#4 G MC CABLE | COPPER CABLE |
| 2 | 2#410, 1#440 N & 1#4 G MC CABLE | COPPER CABLE |
| 3 | 2#250 MCM, 1#250 MCM & 1#4 G MC CABLE | COPPER CABLE |
| 4 | 4#6 - 1" C | COPPER CABLE |
| 5 | 2#8 & 1#8 G IN 1" C | COPPER CABLE |
| 6 | 4#4 & 1#8 G IN 1 1/4" C | COPPER CABLE |
| 7 | 10#14, 1 1/4" C | COPPER CABLE |
| 8 | 2#10 & 1#10 G IN 3/4" C | COPPER CABLE |
| 9 | 4#20 IN 2 1/2" C | COPPER CABLE |
| 10 | 4#40 - 2" C | COPPER CABLE |
| 11 | 4#350 MCM - 3" C | COPPER CABLE |
| 12 | 3 SETS OF 4#250 MCM - (3) 2 1/2" C | COPPER CABLE |
| 13 | 6 SETS OF 4#400 MCM IN (6) 3 1/2" C | COPPER CABLE |
| 14 | 8-4" CONDUITS SLEEVES AS PER CON EDISON APPROVED LAYOUT. | COPPER CABLE |
| 15 | 4 SETS 4#500 MCM IN 4-4" C | COPPER CABLE |
| 16 | 4#1 IN 1 1/4" C | COPPER CABLE |
| 17 | 4 SETS 4#600MCM IN 4-4" C | COPPER CABLE |
| 18 | 5 SETS 4#600MCM IN 5-4" C | COPPER CABLE |
| 19 | 6 SETS 4#600MCM IN 6-4" C | COPPER CABLE |
| 20 | 7 SETS 4#600MCM IN 7-4" C | COPPER CABLE |
| 21 | 4#500 MCM IN 3" C | COPPER CABLE |
| 22 | 6 SETS OF 4#600 MCM IN 6-3.5" C | COPPER CABLE |
| 23 | 4#900 MCM - 4" C | COPPER CABLE |
| 24 | 4#110 - 1 1/2" C | COPPER CABLE |
| 25 | 2 SETS OF 500MCM IN 2-3" C | COPPER CABLE |
| 26 | 4#30 - 2" C | COPPER CABLE |
| 27 | 4#500 - 3 1/2" C | COPPER CABLE |


- COGENERATION NOTES:
- THIS PROJECT INSTALLS TWO (2) 100KW CHP MODULE TECOGEN INV-100 PACKAGED AND ALL NECESSARY EQUIPMENT FOR ITS INTERCONNECTION TO THE CON-ED SYSTEM. INVERTER IS UL 1741 APPROVED.
 - ALL CIRCUIT BREAKERS INDICATED WILL PROVIDE SELECTIVE COORDINATION AND HAVE 200 KAIC RATINGS.
 - THE GENERATOR IS TO BE INSTALLED IN ACCORDANCE WITH ALL APPLICABLE NEW YORK CITY ELECTRICAL CODE, STANDARD AND INTERCONNECTION REQUIREMENTS AS PER CON EDISON ED-2115.
 - IN THE EVENT OF A LOSS OF SUPPLY FROM CON.ED, THE INV-100 CAN BE MANUALLY TRANSFERRED TO SUPPLY SELECTED LOADS FROM DISTRIBUTION PANEL TO TRANSFER SUPPLY ISOLATED LOADS. SEE STANDBY OPERATION PROCEDURES.
 - BOND XO BUSHING TO SERVICE ENTRANCE THROUGH NEUTRAL CONDUCTOR, DO NOT GROUND AT TRANSFORMER.
 - FURNISH & INSTALL 800 AMPERE SHUNT TRIP BREAKER ADJACENT TO HOUSE MAIN 2500 AMPERE SERVICE SWITCH. COORDINATE EXACT LOCATION & CONDUIT ROUTING IN THE FIELD.
 - GROUND TRANSFORMER IN ACCORDANCE WITH NEC 250, CON EDISON REQUIREMENTS & GENERATOR VENDOR PRIOR TO INSTALLATION.
 - CONNECTION OF BECKWITH RELAYS AT THE SERVICE ENTRANCE SHALL BE IN COMPLIANCE WITH CON EDISON.
 - UPON COMPLETION OF THE SYSTEM SHALL BE TESTED IN THE PRESENCE OF THE OWNER REPRESENTATIVE, FACTORY TRAINED TECHNICIAN.
 - PROVIDE ALL POWER AND CONTROL WIRING, RELAYS, CONTACTORS, ETC REQUIRED SHALL BE IN ACCORDANCE WITH MANUFACTURER APPROVED SHOP DRAWING AND INSTALLATION WIRING DIAGRAM
 - ALL WIRING SHALL BE ALUMINUM UNLESS NOTED OTHERWISE
 - PROVIDE CONTROL WIRING BETWEEN EACH ATS & CO-GENERATOR CONTROLLER.
 - COGENERATION ON-SITE ELECTRICAL POWER WILL BE USED ON THE FOLLOWING:
 - A. DURING NORMAL OPERATION THE ON-SITE POWER WILL BE CONNECTED TO THE HOUSE PANEL LOADS.
 - B. DURING EMERGENCY OPERATION THE FOLLOWING LOADS WILL BE SERVED:
 - MECHANICAL ROOMS EMERGENCY LIGHTS
 - CORRIDOR EMERGENCY LIGHTS
 - STAIR LIGHTS
 - EXTERIOR EMERGENCY LIGHTS
 - ELEVATORS #1, 2 & 3.
 - COGENERATION PUMPS AND ANCILLARY EQUIPMENT.
 - DOMESTIC WATER BOOSTER PUMPS
 - KIRK KEY TO DISCONNECT COGEN EDISON CHP PANEL FROM HDP-1 PANEL TO ENABLE OPERATION OF COGEN UNITS DURING EMERGENCY POWER OPERATION.

- SYMBOLS AND ABBREVIATIONS
- 27 UNDERVOLTAGE RELAY
 - 32R REVERSE POWER RELAY
 - 42 CONTACTOR
 - 50 INSTANTANEOUS OVERCURRENT REVERSE POWER RELAY
 - 51 AC CIRCUIT BREAKER
 - 59 OVERVOLTAGE RELAY
 - 81 L/O UNDER-OVER FREQUENCY RELAY
 - 89S LINE SWITCH
 - 89L LOCKABLE LOAD BREAK SWITCH
 - 91 CIRCUIT BREAKER (FIXED MOUNT)
 - FUSED DISCONNECT
 - AS/AF AMP SWITCH/AMP FUSE (FUSED DISCONNECT)
 - AF/AT AMP FRAME/AMP TRIP (CIRCUIT BREAKER)
 - CONTACTOR
 - METERING DEVICE
 - KEY INTERLOCK
 - N.O. NORMALLY OPEN
 - N.C. NORMALLY CLOSED
 - O.O.S. OUT OF SERVICE
 - INVERTER

NOTE: TO THE BEST OF MY KNOWLEDGE, BELIEF AND PROFESSIONAL JUDGMENT, THESE PLANS AND SPECIFICATIONS ARE IN COMPLIANCE WITH THE 2014 NEW YORK ENERGY CONSERVATION CODE (NYECC).

NOTE: THIS PLAN IS APPROVED ONLY FOR WORK INDICATED ON THE APPLICATION SPECIFICATION SHEET. ALL OTHER MATTERS SHOWN ARE NOT TO BE RELIED UPON OR TO BE CONSIDERED AS EITHER BEING APPROVED OR IN ACCORDANCE WITH APPLICABLE CODES.

| | | | | | | | | | | | | | | | | | | | | | | | | | | | |
|--|--|--|--|---|---|--|--|---|----|--------------------|----------|----|-------------------|----------|----|-------------------|----------|----|-------------------|----------|----|----------------------|----------|----|-------------------|----------|--|
| <h1>30-02</h1> <h1>39TH</h1> <h1>Avenue</h1> | CLIENT The Lightstone Group 460 Park Ave, 13th Fl. New York, NY 10022 Tel: 212-616-9969 | ARCHITECT Gerner Kronick + Valcarcel 443 Park Avenue South, 2nd Fl. New York, NY 10016 Tel: 212-679-6362 Fax: 212-679-5877 | STRUCTURAL ENGINEER WSP Cantor Seinuk 228 E 45th St., 3rd Fl. New York, NY 10017 Tel: 212-687-9888 Fax: 646-487-5501 | MEP ENGINEER Ventrop Engineering Consulting Group, PLLC 365 W 34th St. New York, NY 10001 Tel: 212-244-5060 | LANDSCAPE DESIGNER Weintraub Diaz, LLC 19 New Street, Nyack New York, 10960 Tel: 845-353-2500 Fax: 845-353-2599 | PARKING CONSULTANT Philip Habib & Associates 102 Madison Avenue, 11th Fl. New York, NY 10016 Tel: 212-929-5656 Fax: 212-929-5605 | ENVIRONMENTAL CONSULTANT AKRF, INC. 440 Park Ave South, 7th Fl. New York, NY 10016 Tel: 646-388-9829 Fax: 212-447-9942 | Revisions <table border="1"> <tr><td>6.</td><td>ISSUED FOR 100% CD</td><td>07/27/15</td></tr> <tr><td>5.</td><td>ISSUED FOR 80% CD</td><td>03/30/15</td></tr> <tr><td>4.</td><td>ISSUED FOR 50% CD</td><td>02/06/15</td></tr> <tr><td>3.</td><td>ISSUED FOR 25% CD</td><td>12/19/14</td></tr> <tr><td>2.</td><td>ISSUE FOR DOB FILING</td><td>11/07/14</td></tr> <tr><td>1.</td><td>ISSUED FOR 50% DD</td><td>10/14/14</td></tr> </table> | 6. | ISSUED FOR 100% CD | 07/27/15 | 5. | ISSUED FOR 80% CD | 03/30/15 | 4. | ISSUED FOR 50% CD | 02/06/15 | 3. | ISSUED FOR 25% CD | 12/19/14 | 2. | ISSUE FOR DOB FILING | 11/07/14 | 1. | ISSUED FOR 50% DD | 10/14/14 | ELECTRICAL POWER RISER DIAGRAM <h1>E-201.00</h1> Scale: NTS Sheet No.: 42 OUT OF 50 |
| | 6. | ISSUED FOR 100% CD | 07/27/15 | | | | | | | | | | | | | | | | | | | | | | | | |
| 5. | ISSUED FOR 80% CD | 03/30/15 | | | | | | | | | | | | | | | | | | | | | | | | | |
| 4. | ISSUED FOR 50% CD | 02/06/15 | | | | | | | | | | | | | | | | | | | | | | | | | |
| 3. | ISSUED FOR 25% CD | 12/19/14 | | | | | | | | | | | | | | | | | | | | | | | | | |
| 2. | ISSUE FOR DOB FILING | 11/07/14 | | | | | | | | | | | | | | | | | | | | | | | | | |
| 1. | ISSUED FOR 50% DD | 10/14/14 | | | | | | | | | | | | | | | | | | | | | | | | | |
| 30-02 39TH Avenue | | | | | | | | | | | | | | | | | | | | | | | | | | | |

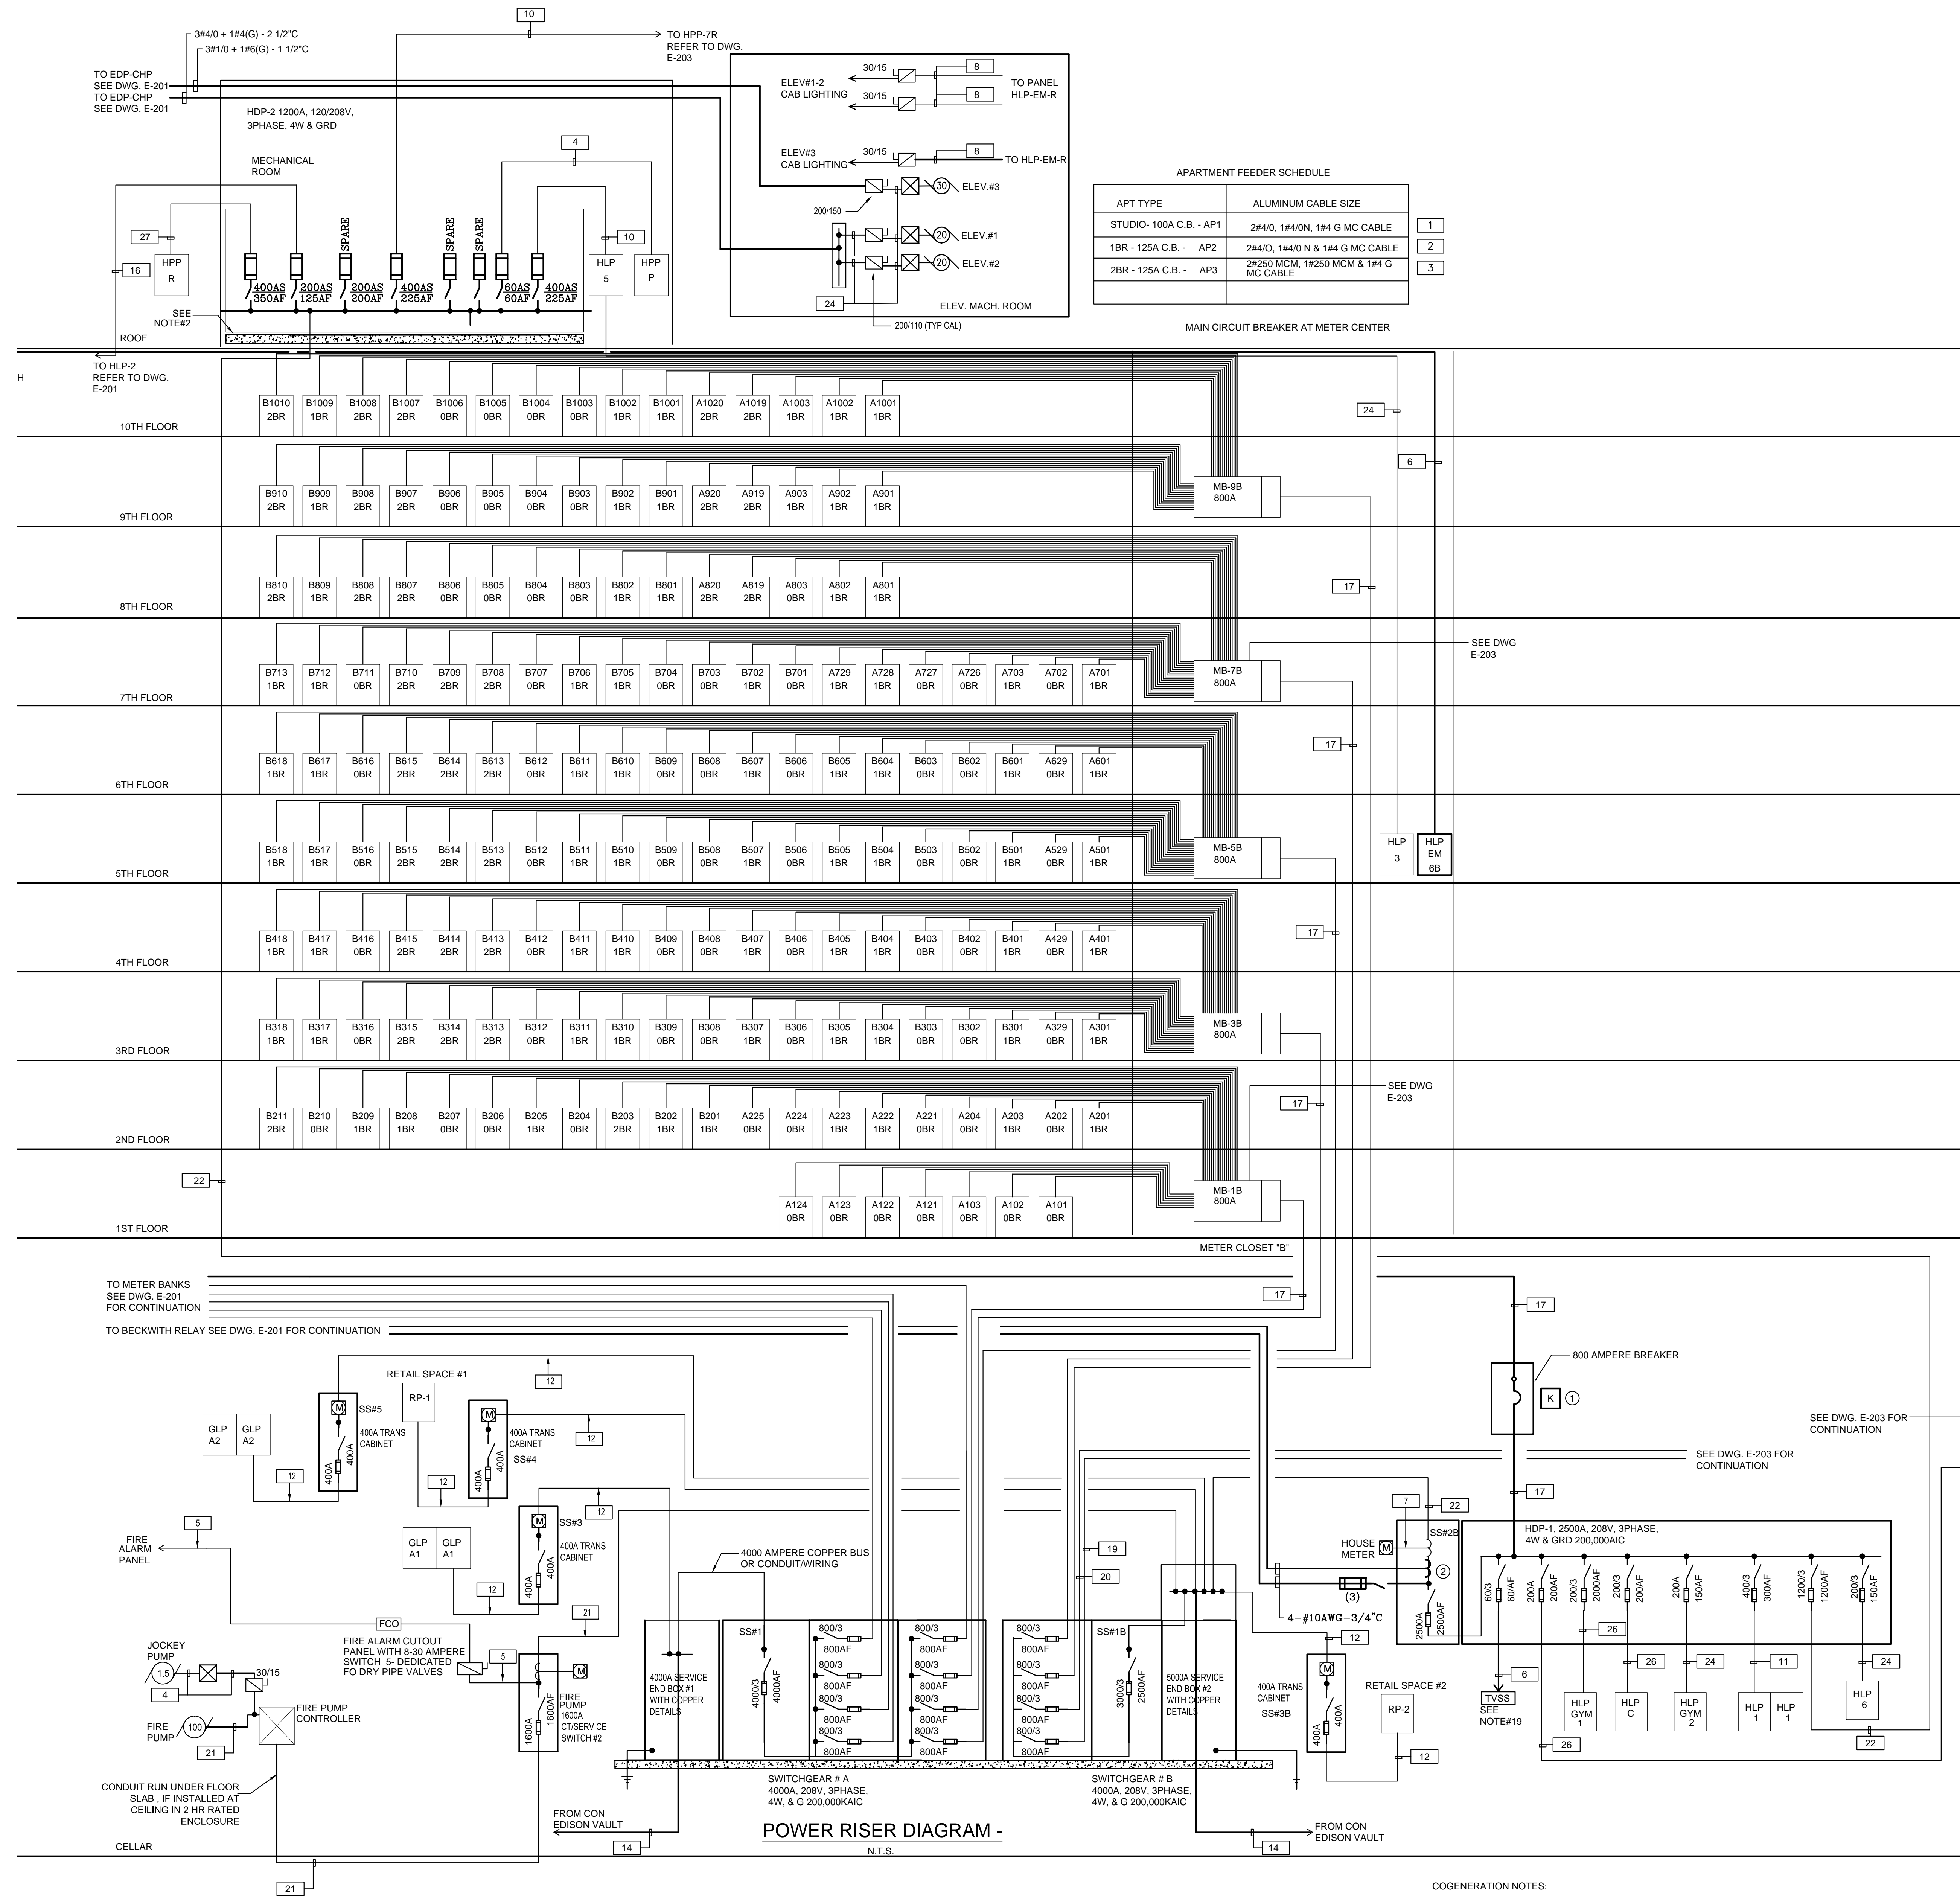

APARTMENT FEEDER SCHEDULE

| APT TYPE | ALUMINUM CABLE SIZE | |
|------------------------|---------------------------------------|---|
| STUDIO-100A C.B. - AP1 | 2#4/0, 1#4/0N, 1#4 G MC CABLE | 1 |
| 1BR - 125A C.B. - AP2 | 2#4/0, 1#4/0 N & 1#4 G MC CABLE | 2 |
| 2BR - 125A C.B. - AP3 | 2#250 MCM, 1#250 MCM & 1#4 G MC CABLE | 3 |

- NOTES:
1. PROVIDE DUAL ELEMENT TIME-DELAY FUSES FOR ELEVATORS.
 2. PROVIDE SUB-FEED LUGS FOR ALL 2 SECTION PANELS. CONTRACTOR IS PERMITTED TO USE SINGLE SECTION 84 POLE PANEL IN LIEU OF 2 SECTION PANEL. REFER TO PANEL SCHEDULE FOR ADDITIONAL INFORMATION.
 3. ELECTRICAL CONTRACTOR IS RESPONSIBLE FOR SHORT CIRCUIT COORDINATION STUDY. ADJUST SHORT CIRCUIT RATING TO PANELS WHERE REQUIRED. STUDY MUST BE PERFORMED PRIOR TO FABRICATION OF SWITCHGEAR, METER CENTER AND PANELS. SUBMIT SHORT CIRCUIT REPORT ALONG WITH THE SWITCHGEAR & PANEL SHOP DRAWINGS.
 4. FIRE ALARM POWER FEEDERS SHALL BE COPPER INSTALLED IN RIGID GALVANIZED STEEL.
 5. G.C TO PROVIDE 4" HOUSE KEEPING PAD FOR ALL FLOOR MOUNTED ELECTRICAL EQUIPMENT.
 6. PROVIDE 8-4" CONDUIT SLEEVES AT THE FOUNDATION WALL TO SERVICE END BOX #1 & 2 IN ACCORDANCE WITH CON EDISON REQUIREMENTS.
 7. WHERE ALUMINUM OR COPPER-CLAD ALUMINUM CABLE ARE USED ALL PANELBOARDS, DISTRIBUTION PANELS, SWITCHES, ETC SHALL BE PROVIDED WITH SUITABLE BUS RATING & LUGS TO ACCEPT THESE CABLES.
 8. ALL COPPER OR COPPER-CLAD CABLES SHALL HAVE A MINIMUM RATING NOT LESS THAN 75DEG C.
 9. PROVIDE 2" EMPTY CONDUIT FROM EACH ELEVATOR PIT TO FRONT DESK FOR "EMS" & SECURITY SYSTEM.
 10. WITHIN THE ELECTRICAL ROOM PROVIDE A MINIMUM OF 3 FEET CLEARANCE FROM ANY ELECTRICAL EQUIPMENT, RAILING, DOORS, ETC. PROVIDE FULLY COORDINATE ROOM LAYOUT FOR THE ENGINEER APPROVAL PRIOR TO COMMENCING ANY WORK.
 11. CONTRACTOR IS REQUIRED TO PREPARE & FILE ELECTRICAL ONE LINE & SWITCHBOARD ROOM LAYOUT WITH NYC BUREAU OF ELECTRICAL CONTROLS FOR APPROVAL PRIOR TO FABRICATION & OR INSTALLATION OF ANY EQUIPMENT.
 12. FIRE PUMP POWER CONDUITS TO BE INSTALLED IN THE CONCRETE SLAB OR PROVIDE 2 HOUR RATED ENCLOSURE.
 13. CONTRACTOR MAY USE CIRCUIT BREAKERS IN LIEU OF SWITCHFUSE IN THE MAIN SWITCHBOARD. CONTRACTOR TO PROVIDE CIRCUIT BREAKER(S) WITH ADEQUATE SHORT CIRCUIT RATING BASED ON SHORT CIRCUIT COORDINATION STUDY.
 14. PROVIDE COPPER CABLES TO FIRE ALARM SYSTEM IN ACCORDANCE WITH 2011 NYC ELECTRICAL CODE.
 15. CABLE SMALLER THAN #10 WIRE SHALL BE SOLID & WIRES LARGER THAN #8 SHALL BE STRANDED.
 16. PROVIDE CONTROL WIRING TO CO-GENERATOR AS PER APPROVED TEGECOR SHOP DRAWINGS. ALL CONTROL WIRING SHALL BE INSTALLED IN 3/4" MINIMUM.
 17. COORDINATE CONTROL WIRING FROM ELEVATOR CONTROLLER TO SELECTOR SWITCH IN LOBBY WITH ELEVATOR VENDOR REQUIREMENTS. INSTALL CONTROL WIRING IN 2" CONDUIT MINIMUM UNLESS DIRECTED OTHERWISE BY VENDOR.
 18. FURNISH & INSTALL TRANSIENT VOLTAGE SURGE SUPPRESSION (TVSS) AT THE MAIN SWITCHBOARD.
 19. TAP JOCKEY PUMP FEED OUTSIDE THE FIRE PUMP CONTROLLER.
 20. ALL PANEL LOCATED ON THE ROOF, WET OR DAMP LOCATION SHALL BE PROVIDED WITH NEMA 3R ENCLOSURE.
 21. WHERE ALUMINUM CABLE ARE USE & FEEDER IS NOT SUITABLE FOR LUGS IN PANEL OR SWITCHES, THE CONTRACTOR SHALL PROVIDE SUITABLE SPLICE BOX AND ASSOCIATED COPPER DETAIL & CONNECT THE EQUIPMENT WITH SUITABLE CABLE RATING TO MATCH AVAILABLE LUGS ON THE EQUIPMENT.
 22. WHERE MC CABLE ARE USE PROVIDE A GROUNDING CONDUCTOR SIZES AS PER NEC 250.

FEEDER SCHEDULE

| DESIGNATION | DESCRIPTION | REMARKS |
|-------------|--|--------------|
| 1 | 2#4/0, 1#4/0N, 1#4 G MC CABLE | COPPER CABLE |
| 2 | 2#4/0, 1#4/0 N & 1#4 G MC CABLE | COPPER CABLE |
| 3 | 2#250 MCM, 1#250 MCM & 1#4 G MC CABLE | COPPER CABLE |
| 4 | 4#6 - 1" C | COPPER CABLE |
| 5 | 2#8 & 1#6 G IN 1" C | COPPER CABLE |
| 6 | 4#4 & 1#6 G IN 1 1/4" C | COPPER CABLE |
| 7 | 1#10 1/4" C | COPPER CABLE |
| 8 | 2#10 & 1#10 G IN 3/4" C | COPPER CABLE |
| 9 | 4#2/2 IN 2 1/2" C | COPPER CABLE |
| 10 | 4#4/0 - 2" C | COPPER CABLE |
| 11 | 4#350 MCM - 3" C | COPPER CABLE |
| 12 | 3 SETS OF 4#250 MCM - (3) 2.5" C | COPPER CABLE |
| 13 | 6 SETS OF 4#400 MCM IN (6) 3.5" C | COPPER CABLE |
| 14 | 8-4" CONDUITS SLEEVES AS PER CON EDISON APPROVED LAYOUT. | COPPER CABLE |
| 15 | 4 SETS 4#500 MCM IN 4-4" C | COPPER CABLE |
| 16 | 4#1 IN 1 1/4" C. | COPPER CABLE |
| 17 | 4 SETS 4#600MCM IN 4-4" C | COPPER CABLE |
| 18 | 5 SETS 4#600MCM IN 5-4" C | COPPER CABLE |
| 19 | 6 SETS 4#600MCM IN 6-4" C | COPPER CABLE |
| 20 | 7 SETS 4#600MCM IN 7-4" C | COPPER CABLE |
| 21 | 4#500 MCM IN 3" C | COPPER CABLE |
| 22 | 6 SETS OF 4#600 MCM IN 6-3.5" C | COPPER CABLE |
| 23 | 4#600 MCM - 4" C. | COPPER CABLE |
| 24 | 4#110 - 1 1/2" C | COPPER CABLE |
| 25 | 3 SETS OF 500MCM IN 2-3" C | COPPER CABLE |
| 26 | 4#30 - 2" C | COPPER CABLE |
| 27 | 4#500 - 3 1/2" C | COPPER CABLE |

NOTE: TO THE BEST OF MY KNOWLEDGE, BELIEF AND PROFESSIONAL JUDGMENT, THESE PLANS AND SPECIFICATIONS ARE IN COMPLIANCE WITH THE 2014 NEW YORK ENERGY CONSERVATION CODE (NYECC).

NOTE: THIS PLAN IS APPROVED ONLY FOR WORK INDICATED ON THE APPLICATION SPECIFICATION SHEET. ALL OTHER MATTERS SHOWN ARE NOT TO BE RELIED UPON OR TO BE CONSIDERED AS EITHER BEING APPROVED OR IN ACCORDANCE WITH APPLICABLE CODES.

COGENERATION NOTES:

1. KIRK-KEY TO DISCONNECT COGEN EDP-CHP PANEL FROM HDP PANEL DURING EMERGENCY OPERATION.

2. ELECTRICAL CONTRACTOR SHALL PROVIDE CON-ED APPROVED 2500'S CTS AND CONNECT TO BECKWITH RELAY AS SHOWN. COORDINATE WIRING REQUIREMENTS WITH CHP EQUIPMENT VENDOR.

30-02
39TH
Avenue

CLIENT
The Lightstone Group
460 Park Ave, 13th Fl.
New York, NY 10022
Tel: 212-616-9969

ARCHITECT
Gerner Kronick + Valcarcel
443 Park Avenue South, 2nd Fl.
New York, NY 10016
Tel: 212-679-6362
Fax: 212-679-5877

STRUCTURAL ENGINEER
WSP Cantor Seinuk
228 E 45th St., 3rd Fl.
New York, NY 10017
Tel: 212-687-9888
Fax: 646-487-5501

MEP ENGINEER
Ventrop Engineering
Consulting Group, PLLC
365 W 34th St.
New York, NY 10001
Tel: 212-244-5060

LANDSCAPE DESIGNER
Weintraub Diaz, LLC
19 New Street, Nyack
New York, 10960
Tel: 845-353-2500
Fax: 845-353-2599

PARKING CONSULTANT
Philip Habib & Associates
102 Madison Avenue, 11th Fl.
New York, NY 10016
Tel: 212-929-5656
Fax: 212-929-5605

ENVIRONMENTAL CONSULTANT
AKRF, INC.
440 Park Ave South, 7th Fl.
New York, NY 10016
Tel: 646-388-9829
Fax: 212-447-9942

Revisions

| No. | Issue | Date |
|-----|----------------------|----------|
| 6. | ISSUED FOR 100% CD | 07/27/15 |
| 4. | ISSUED FOR 80% CD | 03/20/15 |
| 5. | ISSUED FOR 50% CD | 02/06/15 |
| 3. | ISSUED FOR 25% CD | 12/19/14 |
| 2. | ISSUE FOR DOB FILING | 11/07/14 |
| 1. | ISSUED FOR 50% DD | 10/14/14 |

ELECTRICAL POWER RISER DIAGRAM

E-202.00


No. Issue Date Scale: NTS Sheet No.: 43 OUT OF 50

SOUTH STREET

MANHATTAN PLUMBING PLAN

MANHATTAN PLUMBING PLAN

11th STREET

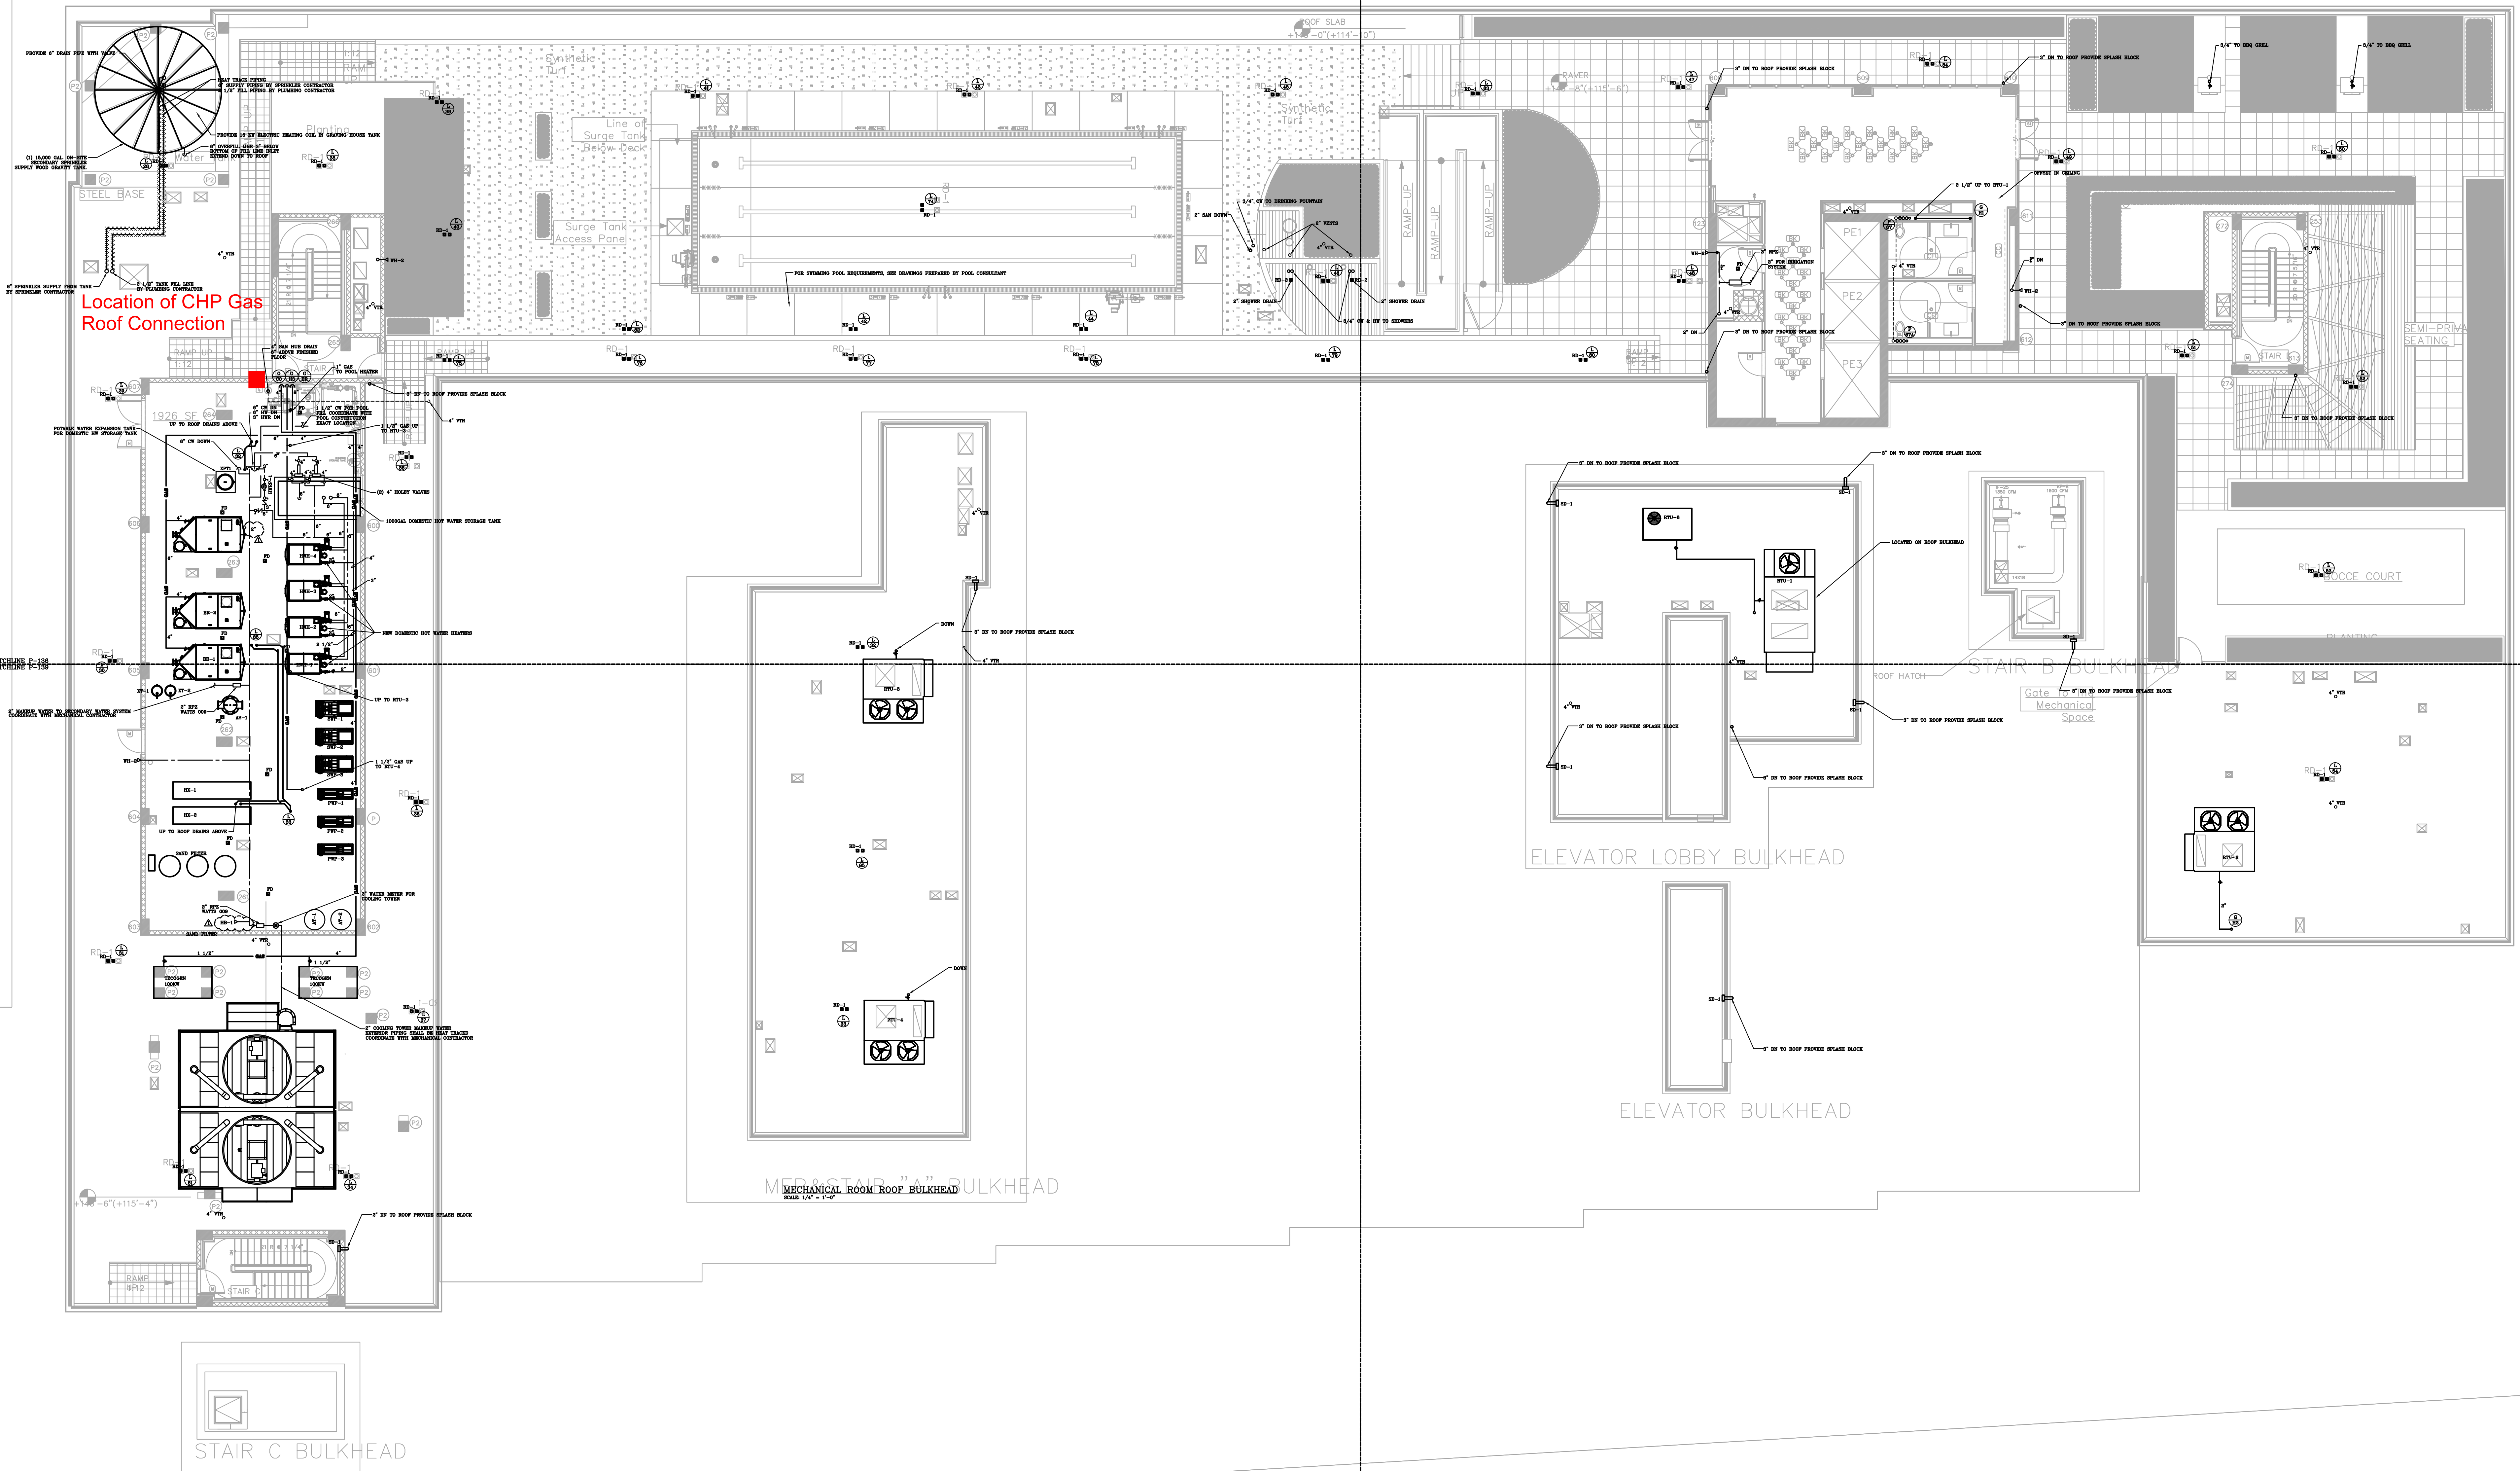

NOTE: TO THE BEST OF MY KNOWLEDGE, BELIEF AND PROFESSIONAL JUDGMENT, THESE PLANS AND SPECIFICATIONS ARE IN COMPLIANCE WITH THE 2014 NEW YORK ENERGY CONSERVATION CODE (NYECC).

NOTE: THIS PLAN IS APPROVED ONLY FOR WORK INDICATED ON THE APPLICATION SPECIFICATION SHEET. ALL OTHER MATTERS SHOWN ARE NOT TO BE RELIED UPON OR TO BE CONSIDERED AS EITHER BEING APPROVED OR IN ACCORDANCE WITH APPLICABLE CODES.

**30-02
39TH
Avenue**

CLIENT
The Lightstone Group
460 Park Ave, 13th Fl.
New York, NY 10022
Tel: 212-616-9969

ARCHITECT
Gerner Kronick + Valcarcel
443 Park Avenue South, 2nd Fl.
New York, NY 10016
Tel: 212-679-6362
Fax: 212-679-5877

STRUCTURAL ENGINEER
WSP Cantor Seinuk
228 E 45th St., 3rd Fl.
New York, NY 10017
Tel: 212-687-9888
Fax: 646-487-5501

MEP ENGINEER
Ventrop Engineering
Consulting Group, PLLC
365 W 34th St.
New York, NY 10001
Tel: 212-244-5060

LANDSCAPE DESIGNER
Weintraub Diaz, LLC
19 New Street, Nyack
New York, 10960
Tel: 845-353-2500
Fax: 845-353-2599

PARKING CONSULTANT
Philip Habib & Associates
102 Madison Avenue, 11th Fl.
New York, NY 10016
Tel: 212-929-5656
Fax: 212-929-5605

ENVIRONMENTAL CONSULTANT
AKRF, INC.
440 Park Ave South, 7th Fl.
New York, NY 10016
Tel: 646-388-9829
Fax: 212-447-9942

| Revisions | | |
|-----------|----------------------|----------|
| 8. | MEP REVISION 1 | 08/28/15 |
| 7. | ISSUED FOR 100% CD | 07/27/15 |
| 6. | DOB COMMENTS | 04/17/15 |
| 5. | ISSUED FOR 80% CD | 03/30/15 |
| 4. | ISSUED FOR 50% CD | 02/06/15 |
| 3. | ISSUED FOR 25% CD | 12/19/14 |
| 2. | ISSUE FOR DOB FILING | 11/07/14 |
| 1. | ISSUED FOR 50% DD | 10/14/14 |
| No. | Issue | Date |


**ROOF
PLUMBING PLAN**

P-135.00

Scale: 1/8" = 1'-0" Sheet No.: 37 OUT OF 58

NOTE: TO THE BEST OF MY KNOWLEDGE, BELIEF AND PROFESSIONAL JUDGMENT, THESE PLANS AND SPECIFICATIONS ARE IN COMPLIANCE WITH THE 2014 NEW YORK ENERGY CONSERVATION CODE (NYECC).

NOTE: THIS PLAN IS APPROVED ONLY FOR WORK INDICATED ON THE APPLICATION SPECIFICATION SHEET. ALL OTHER MATTERS SHOWN ARE NOT TO BE RELIED UPON OR TO BE CONSIDERED AS EITHER BEING APPROVED OR IN ACCORDANCE WITH APPLICABLE CODES.

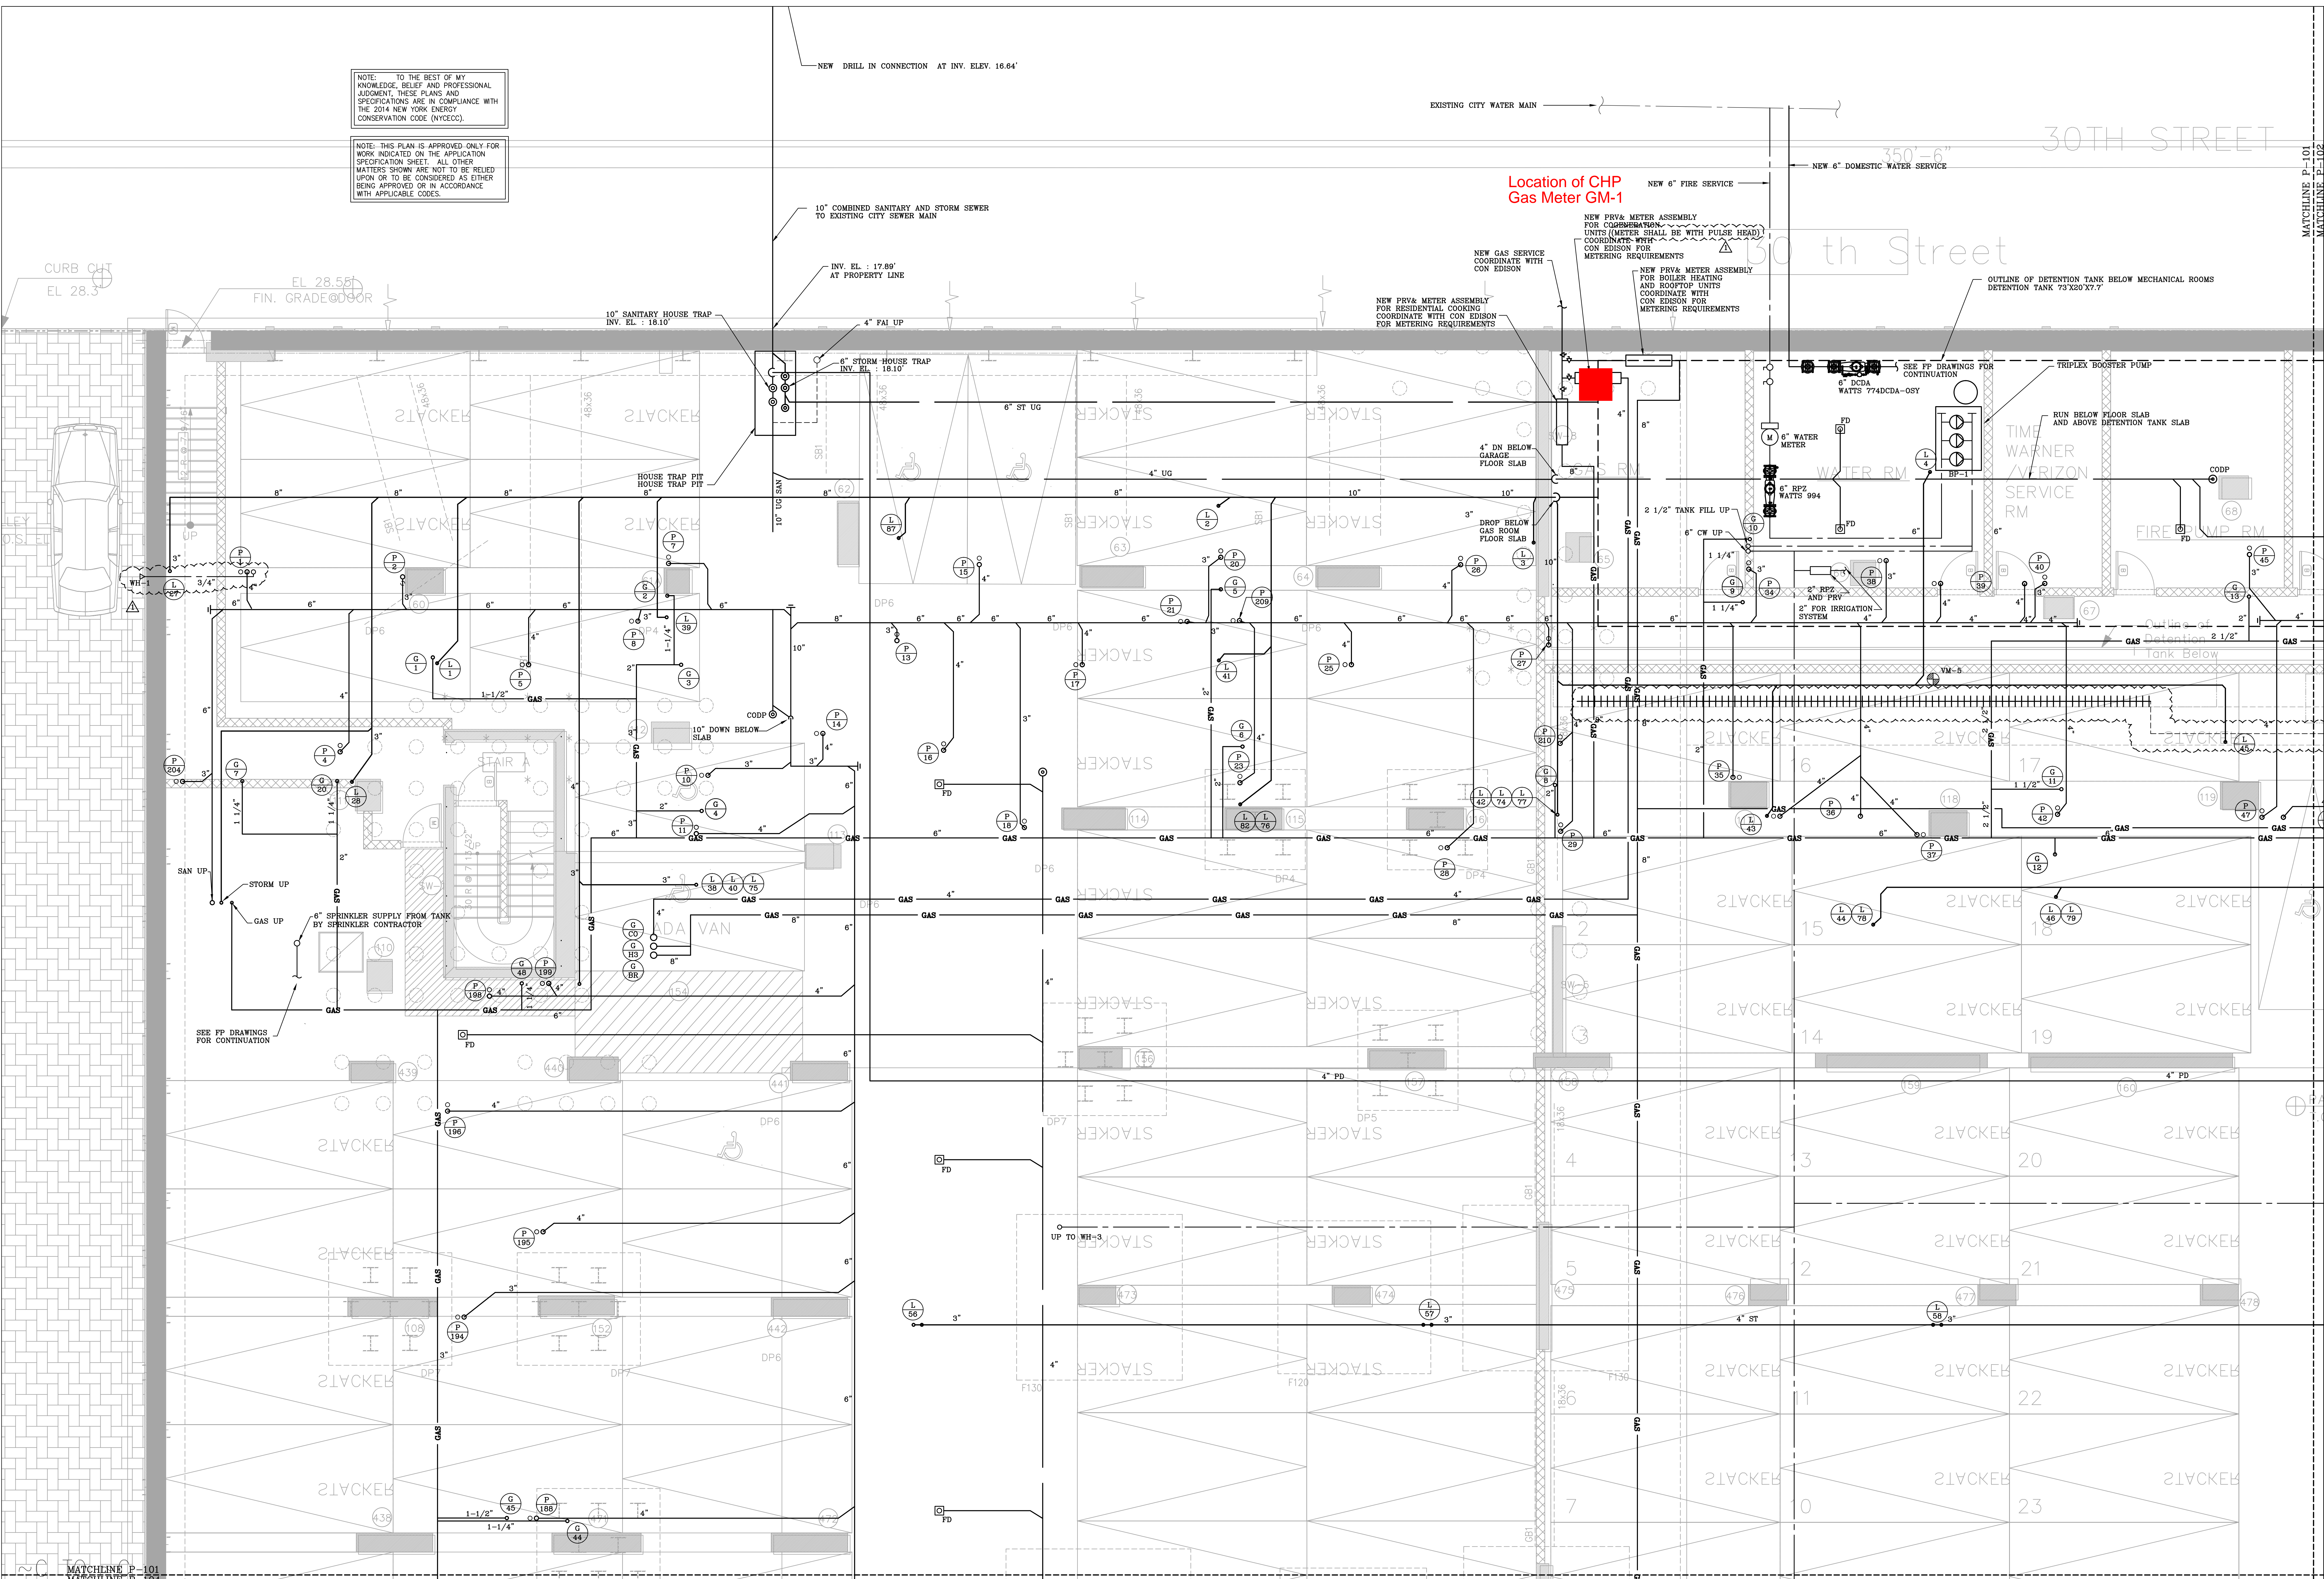

30-02
39TH
Avenue

CLIENT
The Lightstone Group
460 Park Ave, 13th Fl.
New York, NY 10022
Tel: 212-616-9969

ARCHITECT
Gerner Kronick + Valcarcel
443 Park Avenue South, 2nd Fl.
New York, NY 10016
Tel: 212-679-6362
Fax: 212-679-5877

STRUCTURAL ENGINEER
WSP Cantor Seinuk
228 E 45th St., 3rd Fl.
New York, NY 10017
Tel: 212-687-9888
Fax: 646-487-5501

MEP ENGINEER
Ventrop Engineering
Consulting Group, PLLC
365 W 34th St.
New York, NY 10001
Tel: 212-244-5060

LANDSCAPE DESIGNER
Weintraub Diaz, LLC
19 New Street, Nyack
New York, 10960
Tel: 845-353-2500
Fax: 845-353-2599

PARKING CONSULTANT
Philip Habib & Associates
102 Madison Avenue, 11th Fl.
New York, NY 10016
Tel: 212-929-5656
Fax: 212-929-5605

ENVIRONMENTAL CONSULTANT
AKRF, INC.
440 Park Ave South, 7th Fl.
New York, NY 10016
Tel: 646-388-9829
Fax: 212-447-9942

| No. | Issue | Date |
|-----|----------------------|----------|
| 8. | MEP REVISION 1 | 08/28/15 |
| 7. | ISSUED FOR 100% CD | 07/27/15 |
| 6. | DOB COMMENTS | 04/17/15 |
| 5. | ISSUED FOR 30% CD | 03/30/15 |
| 4. | ISSUED FOR 50% CD | 02/06/15 |
| 3. | ISSUED FOR 25% CD | 12/19/14 |
| 2. | ISSUE FOR DOB FILING | 11/07/14 |
| 1. | ISSUED FOR 50% DD | 10/14/14 |

PARTIAL CELLAR FLOOR PLUMBING PLAN

P-101.00

Scale: 1/4" = 1'-0"

Sheet No.: 3 OUT OF 58

Appendix B

Cut Sheets for Key Sensors and Instruments

E5X SERIES

Versatile Energy Monitoring Solution



E50/E51

The E5x Series DIN Rail Meter combines exceptional performance and easy installation to deliver a cost-effective solution for power monitoring applications. The E5x can be installed on standard DIN rail or surface mounted as needed. The Modbus, LON, and BACnet output models offer added flexibility for system integration. The data logging capability (E5xC3 and E5xx5) protects data in the event of a communications or power failure elsewhere in the system. Combinations of serial communication, pulse output, and phase alarms are provided to suit a wide variety of applications. Additional pulse inputs on E5xHx and E50Fx provide an easy way to incorporate simple flow sensors to track gas, water, steam, or other energy forms using a BACnet or LON system.

The E51 models add a bi-directional monitoring feature designed expressly for renewable energy applications, allowing measurement of power imported from the utility grid as well as power exported from the renewable energy source (e.g. solar panels). In this way, a facility administrator can track all energy data, ensuring accuracy in billing and crediting. They are also useful for monitoring loads that use regenerative braking.

SPECIFICATIONS

INPUTS

| | |
|-------------------|---|
| Control Power, AC | 50/60 Hz; 5 VA max.; 90 V min.; UL Maximums: 600 V _{L-L} (347 V _{L-N}); CE Maximum: 300 V _{L-N} |
| Control Power, DC | 3W max.; UL and CE: 125 to 300 Vdc (external DC current limiting required) |
| Voltage Input | UL: 90 V _{L-N} to 600 V _{L-L} ; CE: 90 V _{L-N} to 300 V _{L-N} |

CURRENT INPUT

| | |
|---------------------------------|---|
| Scaling | 5 A to 32,000 A |
| Input Range | 0 to 0.333 V or 0 to 1 V (selectable) CTs must be rated for use with Class 1 voltage inputs |
| Pulse Inputs E5xHx & E50Fx only | Contact inputs to pulse accumulators (one set with E5xH2 and E50F2; two sets with E5xH5 and E51F5)* |

ACCURACY

| | |
|---------------------|---|
| Real Power & Energy | 0.2% (ANSI C12.20, IEC 62053-22 Class 0.2S) |
|---------------------|---|

OUTPUTS

| | |
|---------------|--|
| E50B1 & E5xCx | Real Energy Pulse: N.O. static**; Alarm contacts: N.C. static** |
|---------------|--|

Revenue grade measurements

Meets ANSI C12.20 Class 0.2 standards

High reliability

ANSI C12.20 0.2% accuracy, IEC 62053-22 Class 0.2S on E5xxx

Easy installation

DIN rail or screw mounting options

Multiple applications

Real energy output and phase loss alarm output on E50Bx and E5xCx models...one device serves multiple applications

Data logging

Ensures long term data retrieval and safeguards during power failures (E5xC3 and E5xx5)

Wide CT compatibility

Compatible with CTs from 5 A to 32000 A

APPLICATIONS

- Energy monitoring in building automation systems
- Renewable energy
- Energy management
- Commercial sub-metering
- Industrial monitoring
- Cost allocation

| | |
|-------|---|
| E50Bx | Reactive energy pulse 30 Vac** |
| E5xCx | RS-485 2-wire Modbus RTU (1200 baud to 38.4 kbaud) |
| E5xHx | RS-485 2-wire BACnet MS/TP (9600 baud to 115.2 kbaud) |
| E50Fx | 2-wire LON FT |

MECHANICAL

| | |
|----------|---------------------------------|
| Mounting | DIN Rail or 3-point screw mount |
|----------|---------------------------------|

ENVIRONMENTAL

| | |
|-----------------------|--|
| Altitude of Operation | 3000 m |
| Operating Temp Range | -30 to 70 °C (-22 to 158 °F) |
| Storage Temp Range | -40 to 85 °C (-40 to 185 °F) |
| Humidity Range | <95% RH non-condensing |
| Mounting Location | Not suitable for wet locations. For indoor use only. |

WARRANTY

| | |
|------------------|---------|
| Limited Warranty | 5 years |
|------------------|---------|

AGENCY APPROVALS

| | |
|------------------|---|
| Agency Approvals | UL 508 (Open Type Device), IEC/EN 61010-1, California CSI Solar, ANSI C12.20, Cat III, Pollution Degree 2 |
|------------------|---|



*10 kΩ Vac/dc to 4 to 10 Vdc.


**30 Vac/dc, 100 mA max. (AC: 50/60Hz).



ORDERING INFORMATION


| | E50B1 | E50C2 | E50C3 | E50F2 | E50F5 | E50H2 | E50H5 | E51C2 | E51C3 | E51H2 | E51H5 | |
|--|-------|-------|-------|-------|-------|-------|-------|-------|-------|-------|-------|---|
| MEASUREMENT CAPABILITY - FULL DATA SET | | | | | | | | | | | | |
| Bi-directional Energy Measurements | | | | | | | | | | • | • | • |
| Power (3-phase total and per phase): Real (kW) Reactive (kVAR), and Apparent (kVA) | • | • | • | • | • | • | • | • | • | • | • | • |
| Power Factor: 3-phase average & per phase | • | • | • | • | • | • | • | • | • | • | • | • |
| Present Power Demand: Real (kW), Reactive (kVAR), and Apparent (kVA) | • | • | • | • | • | • | • | • | • | • | • | • |
| Import and Export totals of Present Power Demand: Real (kW), Reactive (kVAR), & Apparent (kVA) | | | | | | | | • | • | • | • | • |
| Peak Power Demand: Real (kW), Reactive (kVAR), and Apparent (kVA) | • | • | • | • | • | • | • | • | • | • | • | • |
| Current (3-phase average and per phase) | • | • | • | • | • | • | • | • | • | • | • | • |
| Voltage: Line-Line and Line-Neutral (3-phase average and per phase) | • | • | • | • | • | • | • | • | • | • | • | • |
| Frequency | • | • | • | • | • | • | • | • | • | • | • | • |
| ANSI C12.20 0.2% accuracy, IEC 62053-22 Class 0.2S | • | • | • | • | • | • | • | • | • | • | • | • |
| Accumulated Net Energy: Real (kWh), Reactive (kVARh), and Apparent (kVAh) | • | • | • | • | • | • | • | • | • | • | • | • |
| Accumulated Real Energy by phase (kWh) | • | • | • | • | • | • | • | • | • | • | • | • |
| Import and Export Accumulators of Real and Apparent Energy | | | | | | | | • | • | • | • | • |
| Reactive Energy Accumulators by Quadrant (3-phase total & per phase) | | | | | | | | • | • | • | • | • |
| Demand Interval Configuration: Fixed or Rolling Block | • | • | • | • | • | • | • | • | • | • | • | • |
| Demand Interval Configuration: External Sync to Comms | | • | • | • | • | • | • | • | • | • | • | • |
| DATA LOGGING | | | | | | | | | | | | |
| Data Logging: 10 16-Bit Configurable (can include Date/Time) Data Buffers | | | • | | | | | | • | | | |
| Data Logging: 3 Timestamped 32-Bit Configurable Data Buffers | | | | | • | | • | | | | | • |
| Store up to 60 days of readings at 15-minute intervals | | | • | | • | | • | | | • | | • |
| OUTPUTS | | | | | | | | | | | | |
| Alarm Output (N.C.) | • | • | • | • | | • | | • | • | • | • | • |
| 1 Pulse Output (N.O.) | | • | • | | | | | • | • | | | |
| 2 Pulse Outputs (N.O.) | • | | | | | | | | | | | |
| RS-485 Serial (Modbus RTU Protocol) | | • | • | | | | | • | • | | | |
| RS-485 Serial (BACnet MS/TP Protocol) | | | | | | • | • | | | • | • | |
| LON FT Serial (LonTalk Protocol) | | | | • | • | | | | | | | |
| INPUTS | | | | | | | | | | | | |
| 2 Pulse Contact Accumulator Inputs | | | | | • | | • | | | | | • |
| 1 Pulse Contact Accumulator Input | | | | • | | • | | | | • | | |

DIMENSIONAL DRAWING

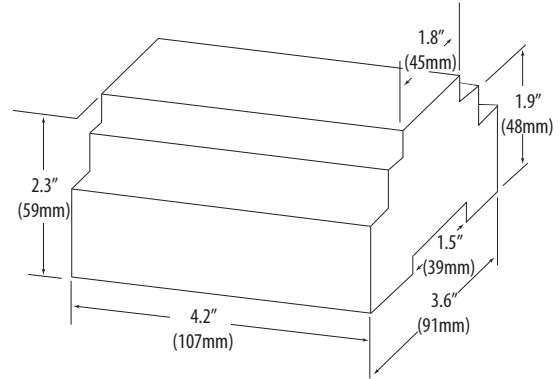


DIN MOUNT CONFIGURATION

Mounting Diagram

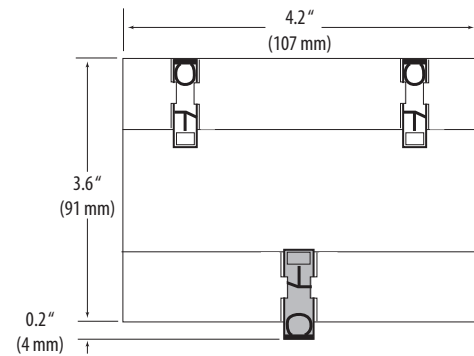

SCREW MOUNT CONFIGURATION

Mounting Diagram

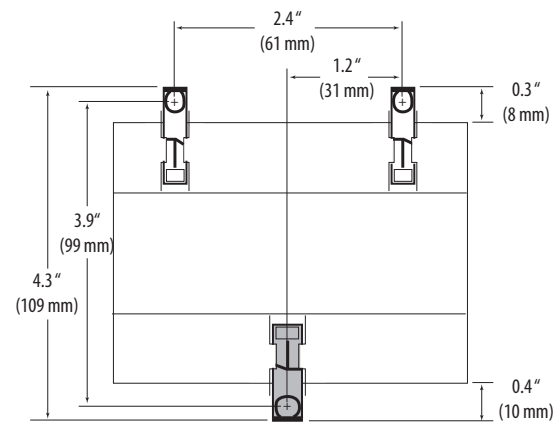



ONICON
Flow and Energy Measurement

System-10 BTU Meter

ONICON's SYSTEM-10 BTU METER is the premier platform for accurately measuring and reporting the thermal energy usage, flow and temperatures required by today's High Performance Buildings.



• Chilled Water • Hot Water • Condenser Water •



DESCRIPTION

The System-10 BTU Meter provides highly accurate thermal energy measurement in chilled water, hot water and condenser water systems based on signal inputs from two matched temperature sensors (included) and any of ONICON's insertion or inline flow meters which are ordered separately. The basic model provides a local indication of energy, flow and temperature data through an alphanumeric display. An isolated solid state dry contact is provided for energy total. Optional analog outputs and network communications are also available.

Whether it's used for chiller plant optimization, CEP monitoring and control, or sub-metering the hydronic energy use across a campus, the System-10 has the versatility and functionality required to integrate seamlessly with your BMS/EMS.

APPLICATIONS

Chilled water, hot water and condenser water systems for:

- Commercial office tenant billing
- Central plant monitoring
- University campus monitoring
- Institutional energy cost allocation
- Performance/efficiency evaluations
- Performance contracting energy monitoring

CALIBRATION

Flow meters and temperature sensors are individually calibrated followed by a complete system calibration.

Field commissioning is also available.

FEATURES

Simple Installation and Commissioning - Factory programmed and ready for use upon delivery. All process data and programming functions are accessible via front panel display and keypad.

Single Source Responsibility - One manufacturer is responsible for every aspect of the energy measurement process ensuring component compatibility and overall system accuracy.

NIST* Traceable Calibration with Certification - Each BTU measurement system is individually calibrated using application specific flow and temperature data and is provided with a certificate of calibration.

Precision Solid State Temperature Sensors - Custom calibrated and matched to an accuracy better than $\pm 0.15^{\circ}\text{F}$ over the calibrated range.

Highly Accurate Flow Meters - ONICON offers a wide variety of insertion and inline type flow measurement technologies including turbine, electromagnetic and ultrasonic sensing. Each type offers unique advantages depending on the application. All ONICON flow meters are individually wet calibrated and designed to operate over a wide flow velocity range with accuracies ranging from $\pm 0.2\%$ to $\pm 2.0\%$ of rate depending on the model.

Complete Installation Package - All mechanical installation hardware, color coded interconnecting cabling and installation instructions are provided to ensure error-free installation and accurate system performance.

Serial Communications - Optional: Provides complete energy, flow and temperature data to the control system through a single network connection, reducing installation costs.



Smart button technology simplifies menu page navigation


*National Institute of Standards and Technology

SPECIFICATIONS*

| | |
|--------------------------|--|
| TEMPERATURE | Overall differential temperature measurement uncertainty of $\leq \pm 0.15^\circ\text{F}$ over the stated range (Includes uncertainty associated with the sensors, transmitters, cabling and calculator input circuitry) Temperature sensors meet EN1434/CSA C900.1 accuracy requirements for 1K sensors for cooling applications, 32°F to 77°F. Temperature sensors meet EN1434/CSA C900.1 accuracy requirements for 2K sensors for heating applications, 140°F to 212°F. |
| CALCULATOR | Computing nonlinearity within $\pm 0.05\%$ Calculator meets EN1434 / CSA C900.1 class 1 accuracy requirements for 2K sensors for all applications. |
| PROGRAMMING | Factory programmed for specific application Field programmable via front panel interface |
| MEMORY | Non-volatile EEPROM memory retains all program parameters and totalized values in the event of power loss. |
| DISPLAY | Alphanumeric LCD displays total energy, total flow, energy rate, flow rate, supply temperature, return temperature, serial number and alarm status Alpha: 16 character, 0.2" high Numeric: 8 digit, 0.4" high Rate Display Range: 0 - 9,999,999 Total Display Range: 0 - 9,999,999 |
| OUTPUT SIGNALS | Isolated solid state dry contact for energy total Contact rating: 100 mA, 50 V Contact duration: 0.5, 1, 2, or 6 sec Analog Output(s) (4-20 mA, 0-10 V or 0-5 V): One or four analog output(s) available for flow rate, energy rate, supply/return temps, or delta-T |
| SERIAL COMMUNICATIONS | BACnet® IP or MS/TP, MODBUS® RTU RS485 or TCP/IP, LONWORKS - TP/FT-10F, Siemens Apogee - P1, Johnson Controls Metasys - N2 |
| TEMPERATURE SENSORS | Solid state sensors are custom calibrated using NIST traceable temperature standards. Current based signal (mA) is unaffected by wire length. |
| TEMPERATURE RANGE | Liquid temperature ranges based on application. See Meter Ordering Information on next page. Ambient temperature range: -20°F to 140°F |
| LIQUID FLOW SIGNAL INPUT | Pulse (frequency) or 4-20 mA input |
| MECHANICAL | Available Electronics Enclosures: Steel NEMA 13, wall mount, 8"x10"x4" NEMA 4 Approximate weight: 12 lbs Temperature Sensor Thermowell Kits: Thermowells and other kit components vary by fluid type, fluid temperature, pipe material and pipe size. Commonly used kits are listed on the previous page. Contact ONICON for additional thermowell kit options, including Hot Tap Installation Kits for retrofit installations. |
| ELECTRICAL | Input Power: Based on BTU meters configured for network connection without the analog outputs: 24 VAC, 50/60 Hz, 500 mA 120 VAC, 50/60 Hz, 200 mA 240 VAC, 50 Hz, 150 mA Internal Supply: Provides 24 VDC at 200 mA to electronics and select flow meters Wiring: Temperature signals: Use 18-22 ga twisted shielded pair Flow signals: Use 18-22 ga - see flow meter specification sheet for number of conductors. |

* SPECIFICATIONS subject to change without notice.

TYPICAL INSERTION METER INSTALLATION

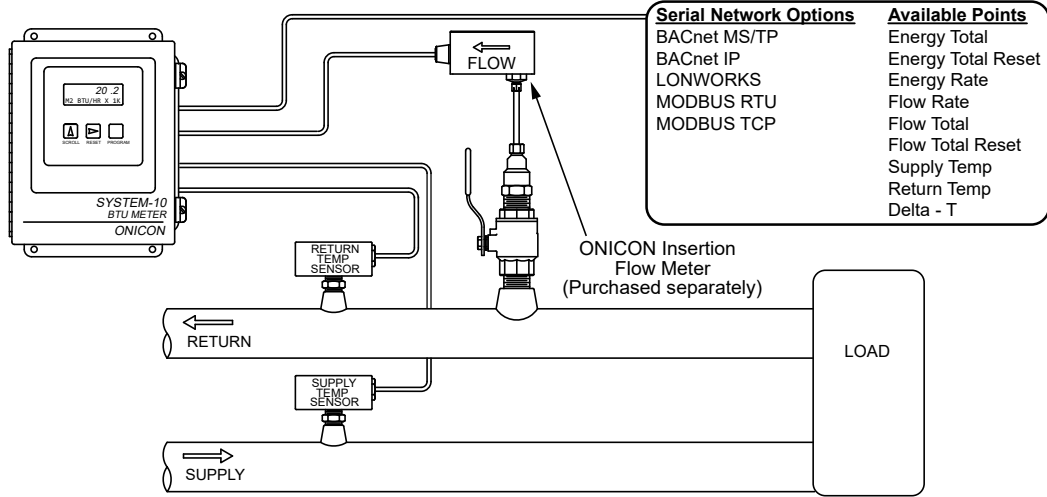

COMPATIBLE FLOW METERS

AVAILABLE OUTPUTS



METER ORDERING INFORMATION

Meter Model Number Coding = SYS-10-ABCD-EFGG

A = Electronics Enclosure

- 1 = NEMA 13 enclosure with LCD display
- 2 = NEMA 4 enclosure with LCD display

B = Input Power

- 1 = 24 VAC, 12 VA
- 2 = 120 VAC, 15 VA
- 3 = 240 VAC, 17.5 VA

C = Serial Communications

- 0 = No serial communications provided
- 1 = RS485, BACnet MS/TP
- 2 = RS485, MODBUS RTU
- 3 = BACnet IP
- 4 = MODBUS TCP/IP
- 5 = DualNet serial communications, IP and RS485
- 8 = LonWorks

D = Analog Output

- 0 = No analog output
- 1 = Single (1) isolated analog output
- 2 = Four (4) isolated analog outputs (Not available when C=5)

E = Auxiliary Pulse Inputs

- 0 = (1) Directional pulse input only
- 1 = (1) Directional pulse and auxiliary pulse input

F = Auxiliary Pulse Outputs

- 1 = Three (3) pulse outputs, dry contact

GG = Temperature Sensor

- 01 = Matched pair of current (mA) based sensors, CHW/CW range
- 02 = Matched pair of current (mA) based sensors, HHW range
- S1 = Matched pair of current (mA) based sensors, 122°F to 302°F range
- S4 = Matched pair of current (mA) based sensors, 80°F to 400°F range